

MISSISSIPPI DEPARTMENT OF NATURAL RESOURCES

Bureau of Land and Water Resources

Southport Mall

P.O. Box 10631


Jackson, Mississippi 39209

WATER WELL DRILLERS LOG

Hancock
L 2808


July 10 1986 Ward Well Dr. Hancock
date well completed firm name county well located

LANDOWNER: <u>Alden Heaphy</u> <u>Bali St.</u> <u>Reaington, Mrs.</u> (mailing address)	description of formations encountered	from	to
	<u>clay</u>	<u>0</u>	<u>19</u>
	<u>ss</u>	<u>19</u>	<u>32</u>
	<u>clay</u>	<u>32</u>	<u>84</u>
	<u>Coar sd</u>	<u>84</u>	<u>105</u>
WELL LOCATION:			
sec. <u>28</u> T. <u>9</u> N. R. <u>16</u> E			
<u>1</u> miles (distance) <u>S</u> (direction) of <u>Reaington</u> (nearest town)			
WELL PURPOSE: <u>None</u> (home, irrigation, municipal, industrial)			
WELL COMPLETION DATA:			
(1) diameter (inches) <u>2'</u>			
(2) total depth (feet) <u>105</u>			
(3) static water level (feet) <u>6</u> <u>below</u> top of ground.			
(4) casing <u>PVC</u> <u>95</u> (material) (depth)			
_____ (size) If telescope see back.			
(5) screen <u>10'</u> _____ (length) (depth to top)			
<u>2"</u> _____ (size) (material)			
(6) pump <u>own</u> _____ (HP) (yield gpm)			
_____ (type power)			
(7) electric log <u>NO</u> (yes or no)			
_____ <u>N/A</u> (organization running log)			
(8) how well bottom plugged <u>BWV</u>			
DRILLERS REMARKS: <u>N/A</u>			

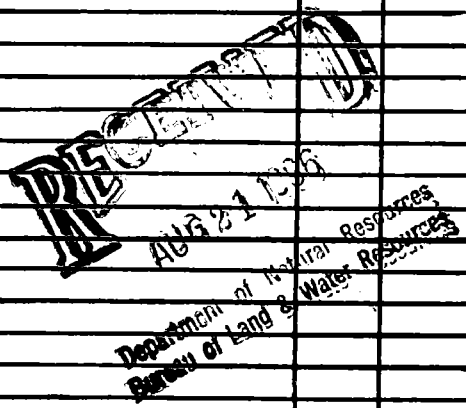

If well telescopes please sketch and show depths.

GROUND LEVEL

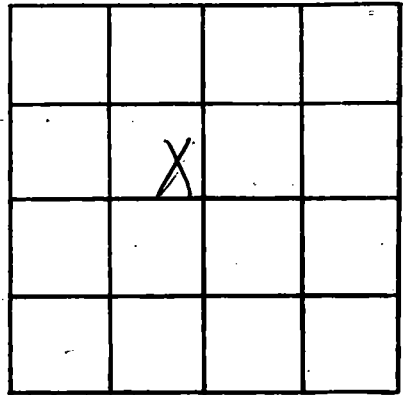

SECTION 28

Please indicate well location X.

ADDITIONAL INFORMATION

If more than one screen, show locations of each on sketch.