

MISSISSIPPI DEPARTMENT OF NATURAL RESOURCES

Bureau of Land and Water Resources

Southport Mall

P.O. Box 10631

Jackson, Mississippi 39209

WATER WELL DRILLERS LOG

Hancock
L-2088

July 16 1986 Ward Well Drg. Hancock
date well completed firm name county well located

LANDOWNER Warren F. Skavon
7th St.
Rollington, Miss.
(mailing address)

description of formations encountered

from to

WELL LOCATION:
sec. 14 T-9 N R-16 E
1 miles E of Rollington
(distance) (direction) (nearest town)

Clay 0 12
Cl. Sd. 12 36
Clay 36 95
Coarse Sd. 95 115

WELL PURPOSE: Home
(home, irrigation, municipal, industrial)

WELL COMPLETION DATA:


RECEIVED
AUG 21 1986
Department of Natural Resources
Bureau of Land & Water Resources

- (1) diameter (inches) 2"
- (2) total depth (feet) 115
- (3) static water level (feet) 16 below top of ground.
- (4) casing PVC 105
(material) (depth)
 if telescope see back.
(size)
- (5) screen 10' -
2" (length) (depth to top)
 PVC
(size) (material)
- (6) pump over -
(HP) (yield gpm)
EL
(type power)
- (7) electric log NO
(yes or no)
N/A
(organization running log)
- (8) how well bottom plugged B W U

DRILLERS REMARKS: N/A

If well telescopes please sketch and show depths.

GROUND LEVEL

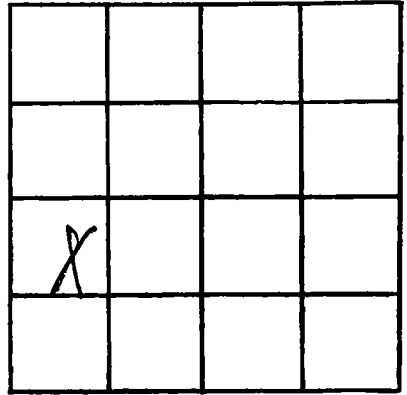

SECTION 14

Please indicate well location X.

ADDITIONAL INFORMATION

If more than one screen,
show locations of each on sketch.