

MISSISSIPPI DEPARTMENT OF NATURAL RESOURCES

Bureau of Land and Water Resources

P.O. Box 10631

Jackson, Mississippi 39209

WATER WELL DRILLERS LOG

COUNTY WELL LOCATED HANCOCK
WELL NUMBER L 1092
DATE WELL COMPLETED 10-27-86

PERMIT NUMBER
NAME OF DRILLING FIRM WARD WELL DRG.
RT. 2, BOX 350C, B.S.L.

NAME & MAILING ADDRESS OF LANDOWNER Steven Singleton			
Riverwind Drive			
Reverington, Ms.			
WELL LOCATION: SEC	TOWNSHIP	RANGE	
28	9	N 16 E	
DISTANCE	DIRECTION	NEAREST TOWN	
1 Miles	S	of Reverington	
OTHER LANDMARK East Pearl River			
WELL PURPOSE: Home, Irrigation, Municipal, Industrial, Fish Pond, etc. Camp			

PUMP DATA		
PUMP TYPE (Circle One): Submersible, Turbine, Jet, Flowing Well, Other (Describe) OWNERS		
POWER TYPE (Circle One): Electric, Tractor, Diesel, Gasoline, Butane, Other (Describe)		
Pump Capacity (GPM)	No. of Stages	Setting Depth FT.
PUMP TEST Well yielded _____ GPM with a drawdown of _____ ft. after _____ hours of pumping		

WELL DATA		
Well Depth 290	Casing Diameter (In.) 2"	Casing Length (Ft.) 280
Type of Casing SCH. 40 PVC	Hole Depth 290	Depth to Static Water Level - 3 ft.
TYPE OF COMPLETION: (Circle One or More): Gravel Packed, Underreamed, Telescoped, Natural Development , Open Hole, Other (Describe) Backfilled		
Top of Lap Pipe or Reduction in Casing FEET IF TELESCOPED OR MORE THAN ONE SCREEN: USE BACK PAGE		

LOG DATA	
TYPE OF LOG RUN (Circle One): No Log Run Electric, Gamma Ray, Density, Sonic, Neutron, Other (Describe)	
Name of Organization Running Log	

SCREEN DATA		
Diameter - Inches 2"	Length - Feet 10 ft.	Slot Size - Inches 8 slot
Screen Type SCH. 80 PVC	Depth to Bottom - Feet - 290	

GEOLOGIC DATA (Office Use Only)			
Surface Elev.	Geologic Unit	Unit Thickness	Depth to Top
Subs. SWL	Date	Analysis	Aquifer Test
Driller's Remarks <div style="text-align: center; font-size: 2em; font-weight: bold; opacity: 0.5;">RECEIVED</div>			

DESCRIPTION OF FORMATIONS ENCOUNTERED	FROM	TO
Fill	0	3
SdY CLAY	3	20
Sd	20	62
Sd - PEA GRAVEL	62	73
Clay	73	84
Sd	84	135
CLAY - SILT	135	265
Coarse Sd	265	290


DEC 22 1986

FORMATIONS (Continued)	FROM	TO
Department of Natural Resources		
Bureau of Land & Water Resources		

IF MORE SPACE IS NEEDED, USE BACK

If well telescopes please
sketch and show depths.

GROUND LEVEL

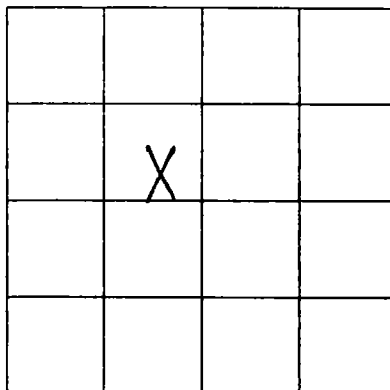

SECTION 28

Please indicate well location X.

ADDITIONAL INFORMATION

If more than one screen,
show location of each on sketch.