

MISSISSIPPI DEPARTMENT OF NATURAL RESOURCES

Bureau of Land and Water Resources

P.O. Box 10631

Jackson, Mississippi 39209

WATER WELL DRILLERS LOG

COUNTY WELL LOCATED HANCOCK	
WELL NUMBER L 2084	CODED
DATE WELL COMPLETED JULY 22, 1987	

PERMIT NUMBER
NAME OF DRILLING FIRM WARR WELL DRG.
RT. 2, BOX 350C, BSL, MS

NAME & MAILING ADDRESS OF LANDOWNER TOMMY WHITE			
GENERAL DELIVERY			
PEARLINGTON MS.			
WELL LOCATION: SEC	TOWNSHIP	RANGE	
	19 9	N 16	E
DISTANCE	DIRECTION	NEAREST TOWN	
— Miles	—	Pearlington	
OTHER LANDMARK —			
WELL PURPOSE: Home, Irrigation, Municipal, Industrial, Fish Pond, etc. HOME			

PUMP DATA		
PUMP TYPE (Circle One): Submersible, Turbine, Jet, Flowing Well, Other (Describe) OWNERS		
POWER TYPE (Circle One): Electric, Tractor, Diesel, Gasoline, Butane, Other (Describe) _____		
Pump Capacity (GPM)	No. of Stages	Setting Depth FT.
PUMP TEST		
Well yielded _____ GPM with a drawdown of _____ ft. after _____ hours of pumping		


WELL DATA		
Well Depth 115 FT.	Casing Diameter (In.) 2"	Casing Length (Ft.) 105 FT.
Type of Casing SCA. 40 PVC	Hole Depth 115 FT.	Depth to Static Water Level - 8 FT.
TYPE OF COMPLETION: (Circle One or More): Gravel Packed, Underreamed, Telescoped, Natural Development, Open Hole, Other (Describe) BWU + AN		
Top of Lap Pipe or Reduction in Casing FEET IF TELESCOPED OR MORE THAN ONE SCREEN: USE BACK PAGE		

LOG DATA	
TYPE OF LOG RUN (Circle One): Electric, Gamma Ray, Density, Sonic, No Log Run , Neutron, Other (Describe) _____	
Name of Organization Running Log	

SCREEN DATA		
Diameter - Inches 2"	Length - Feet 10 FT.	Slot Size - Inches .0085 LOT
Screen Type SCA. 80 PVC	Depth to Bottom - Feet - 115	

GEOLOGIC DATA (Office Use Only)			
Surface Elev.	Geologic Unit	Unit Thickness	Depth to Top
Subs. SWL	Date	Analysis	Aquifer Test
Driller's Remarks N/A			

DESCRIPTION OF FORMATIONS ENCOUNTERED	FROM	TO

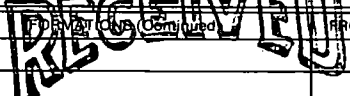

OCT 09 1987

Department of Natural Resources
Bureau of Land & Water Resources

IF MORE SPACE IS NEEDED, USE BACK

If well telescopes please sketch and show depths.

GROUND LEVEL

	X		

SECTION 19

Please indicate well location X.

ADDITIONAL INFORMATION

If more than one screen, show location of each on sketch.