

MISSISSIPPI DEPARTMENT OF NATURAL RESOURCES
Bureau of Land and Water Resources

P.O. Box 10631

Jackson, Mississippi 39209

WATER WELL DRILLERS LOG

COUNTY WELL LOCATED <i>Hancock</i>
WELL NUMBER <i>2-2070</i>
CODED
DATE WELL COMPLETED <i>10-16-87</i>

PERMIT NUMBER
NAME OF DRILLING FIRM <i>Wood Well Drilling</i>
<i>Pt. 2, Box 3506 B.S.S. Inc.</i>

NAME & MAILING ADDRESS OF LANDOWNER <i>Justin Leviton</i>
<i>Samatra St.</i>
<i>Pearlington, ms.</i>
WELL LOCATION: SEC TOWNSHIP RANGE <i>28 9 S 16 W</i>
DISTANCE DIRECTION NEAREST TOWN <i>1/2 Miles S of Pearlington</i>
OTHER LANDMARK <i>Bell Isle Sude.</i>
WELL PURPOSE: Home, Irrigation, Municipal, Industrial, Fish Pond, etc. <i>Home</i>


PUMP DATA		
PUMP TYPE (Circle One): Submersible, Turbine, Jet, Flowing Well, Other (Describe) <i>owner</i>		
POWER TYPE (Circle One): Electric, Tractor, Diesel, Gasoline, Butane, Other (Describe)		
Pump Capacity (GPM)	No. of Stages	Setting Depth FT.
PUMP TEST		
Well yielded _____ GPM with a drawdown of _____ ft. after _____ hours of pumping		

WELL DATA		
Well Depth <i>125 ft.</i>	Casing Diameter (In.) <i>2"</i>	Casing Length (Ft.) <i>115 ft.</i>
Type of Casing <i>Sk. 40 PVC</i>	Hole Depth <i>125 ft.</i>	Depth to Static Water Level <i>-4 ft.</i>
TYPE OF COMPLETION: (Circle One or More): Gravel Packed, Underreamed, Telescoped, Natural Development, Open Hole, Other (Describe) <i>Backwash - air</i>		
Top of Lap Pipe or Reduction in Casing FEET IF TELESCOPED OR MORE THAN ONE SCREEN: USE BACK PAGE		

LOG DATA	
TYPE OF LOG RUN (Circle One): Electric, Gamma Ray, Density, Sonic, No Log Run , Neutron, Other (Describe)	
Name of Organization Running Log	


SCREEN DATA		
Diameter - Inches <i>2"</i>	Length - Feet <i>10 ft.</i>	Slot Size - Inches <i>.008</i>
Screen Type <i>Sk. 80 PVC</i>	Depth to Bottom - Feet <i>- 125</i>	

GEOLOGIC DATA (Office Use Only)			
Surface Elev.	Geologic Unit	Unit Thickness	Depth to Top
Subs. SWL	Date	Analysis	Aquifer Test
Driller's Remarks <i>N/A</i>			

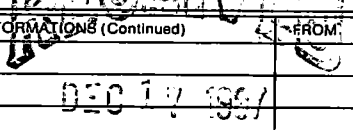DESCRIPTION OF FORMATIONS ENCOUNTERED	FROM	TO	FORMATIONS (Continued)	FROM	TO
<i>clay</i>	<i>0</i>	<i>21</i>			
<i>gsd</i>	<i>21</i>	<i>35</i>			
<i>clay</i>	<i>35</i>	<i>94</i>			
<i>gsd</i>	<i>94</i>	<i>125</i>			
			Department of Natural Resources Bureau of Land & Water Resources		
			IF MORE SPACE IS NEEDED, USE BACK		

If well telescopes please sketch and show depths.

GROUND LEVEL

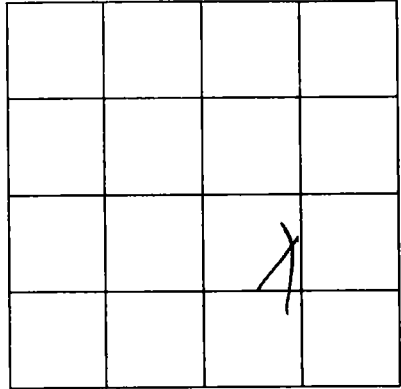

SECTION 21

Please indicate well location X.

ADDITIONAL INFORMATION

If more than one screen,
show location of each on sketch.