

MISSISSIPPI DEPARTMENT OF NATURAL RESOURCES
Bureau of Land and Water Resources

P.O. Box 10631

Jackson, Mississippi 39209

WATER WELL DRILLERS LOG

COUNTY WELL LOCATED HANCOCK	
WELL NUMBER L 2098	CODED
DATE WELL COMPLETED 12-2-87	

PERMIT NUMBER
NAME OF DRILLING FIRM WARD WELL DRG.
RT. 2, BX 350C, A.S.L. MS.

NAME & MAILING ADDRESS OF LANDOWNER Louise M. Martin			
Hwy 604 - 90			
Pearlington, Ms.			
WELL LOCATION: SEC	TOWNSHIP	RANGE	
21	9	16	
DISTANCE	DIRECTION	NEAREST TOWN	
		Pearlington	
OTHER LANDMARK			
WELL PURPOSE: Home, Irrigation, Municipal, Industrial, Fish Pond, etc. Home			

PUMP DATA		
PUMP TYPE (Circle One): Submersible, Turbine, Jet Flowing Well, Other (Describe) _____		
POWER TYPE (Circle One): Electric , Tractor, Diesel, Gasoline, Butane, Other (Describe) _____		
Pump Capacity (GPM) 10	No. of Stages 1	Setting Depth FT.
PUMP TEST		
Well yielded _____ GPM with a drawdown of _____ ft. after _____ hours of pumping		

WELL DATA		
Well Depth 450'	Casing Diameter (In.) 2"	Casing Length (Ft.) 440'
Type of Casing Sch. 40 pipe	Hole Depth 450'	Depth to Static Water Level - 2 ft.
TYPE OF COMPLETION: (Circle One or More): Gravel Packed, Underreamed, Telescoped, Natural Development, Open Hole, Other (Describe) Backwashed - air lumped		
Top of Lap Pipe or Reduction in Casing		
FEET	IF TELESCOPED OR MORE THAN ONE SCREEN: USE BACK PAGE	

LOG DATA	
TYPE OF LOG RUN (Circle One): Electric, Gamma Ray, Density, Sonic, No Log Run , Neutron, Other (Describe) _____	
Name of Organization Running Log	

SCREEN DATA		
Diameter - Inches 2"	Length - Feet 10'	Slot Size - Inches .008
Screen Type Sch. 80 PVC	Depth to Bottom - Feet - 450	


GEOLOGIC DATA (Office Use Only)			
Surface Elev.	Geologic Unit	Unit Thickness	Depth to Top
Subs. SWL	Date	Analysis	Aquifer Test
Driller's Remarks N/A			

DESCRIPTION OF FORMATIONS ENCOUNTERED	FROM	TO
clay	0	25
sd	25	36
clay	36	86
sd	86	120
sd clay	120	160
clay	160	270
fine sd	270	295
clay - silt	295	430
med. coarse sd	430	450

FORMATIONS (Continued)		FROM	TO
RECEIVED			
FEB 18 1988			
Department of Natural Resources Bureau of Land & Water Resources			
IF MORE SPACE IS NEEDED, USE BACK			

If well telescopes please
sketch and show depths.

GROUND LEVEL

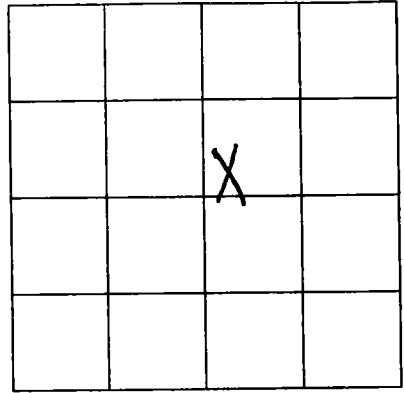

SECTION 21

Please indicate well location X.

ADDITIONAL INFORMATION

If more than one screen,
show location of each on sketch.