

MISSISSIPPI DEPARTMENT OF NATURAL RESOURCES
Bureau of Land and Water Resources

P.O. Box 10631
Jackson, Mississippi 39209
WATER WELL DRILLERS LOG

COUNTY WELL LOCATED <i>Hancock</i>		PERMIT NUMBER
WELL NUMBER <i>2099</i>	CODED	NAME OF DRILLING FIRM <i>Wood Well Dlg.</i>
DATE WELL COMPLETED <i>April 2, 1988</i>		<i>Bay St. Louis, ms.</i>

NAME & MAILING ADDRESS OF LANDOWNER <i>Earnest Smith</i>		
<i>Bell Isle Sude.</i>		
<i>Reaughton, ms.</i>		
WELL LOCATION:	SEC	TOWNSHIP RANGE
	<i>28</i>	<i>9</i> <i>N</i> <i>16</i> <i>W</i>
DISTANCE	DIRECTION	NEAREST TOWN
<i>1/2</i> Miles	<i>S</i>	<i>Reaughton</i>
OTHER LANDMARK <i>Bell Isle Sude.</i>		
WELL PURPOSE: Home, Irrigation, Municipal, Industrial, Fish Pond, etc. <i>Home</i>		

PUMP DATA		
PUMP TYPE (Circle One): Submersible, <u>Turbine</u> , Jet, Flooding Well, Other (Describe) <i>Shallow well jet</i>		
POWER TYPE (Circle One): Electric, Tractor, Diesel, Gasoline, Butane, Other (Describe)		
Pump Capacity (GPM) <i>12</i>	No. of Stages <i>1</i>	Setting Depth FT.
PUMP TEST		
Well yielded _____ GPM with a drawdown of _____ ft. after _____ hours of pumping		

WELL DATA		
Well Depth <i>625</i>	Casing Diameter (In.) <i>2"</i>	Casing Length (Ft.) <i>605</i>
Type of Casing <i>Sch. 40 PVC</i>	Hole Depth <i>625</i>	Depth to Static Water Level <i>- 1 ft.</i>
TYPE OF COMPLETION: (Circle One or More): Gravel Packed, Underreamed, Telescoped, Natural Development, Open Hole, <u>Other</u> (Describe) <i>backwashed - air</i>		
Top of Lap Pipe or Reduction in Casing FEET IF TELESKOPED OR MORE THAN ONE SCREEN: USE BACK PAGE		

LOG DATA	
TYPE OF LOG RUN (Circle One): Electric, Gamma Ray, Density, Sonic, <u>No Log Run</u> , Neutron, Other (Describe)	
Name of Organization Running Log	

SCREEN DATA		
Diameter - Inches <i>2"</i>	Length - Feet <i>20'</i>	Slot Size - Inches <i>.008</i>
Screen Type <i>Sch. 80 PVC</i>	Depth to Bottom - Feet <i>625</i>	

GEOLOGIC DATA (Office Use Only)			
Surface Elev.	Geologic Unit	Unit Thickness	Depth to Top
Subs. SWL	Date	Analysis	Aquifer Test


Driller's Remarks <i>N/A</i>

DESCRIPTION OF FORMATIONS ENCOUNTERED	FROM	TO	FORMATIONS (Continued)	FROM	TO
<i>Clay</i>	<i>0</i>	<i>24</i>	RECEIVED <i>JUL 18 1988</i>		
<i>sd</i>	<i>24</i>	<i>30</i>			
<i>Clay</i>	<i>30</i>	<i>86</i>			
<i>Red Shaly Sd</i>	<i>86</i>	<i>115</i>			
<i>Clay - Silt</i>	<i>115</i>	<i>452</i>			
<i>Fine sd</i>	<i>452</i>	<i>485</i>			
<i>Clay</i>	<i>485</i>	<i>570</i>			
<i>Coarse sd</i>	<i>570</i>	<i>625</i>			

IF MORE SPACE IS NEEDED, USE BACK

If well telescopes please sketch and show depths.

GROUND LEVEL

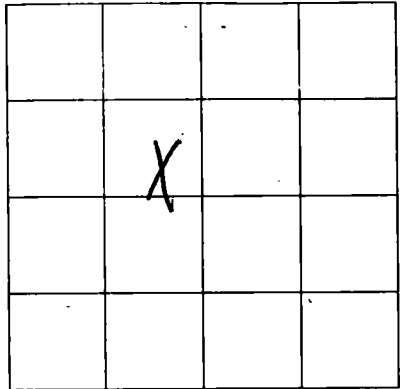

SECTION 28

Please indicate well location X.

ADDITIONAL INFORMATION

If more than one screen,
show location of each on sketch.