




If well telescopes please sketch and show depths.



LOT 22  
Betch RD

GROUND LEVEL

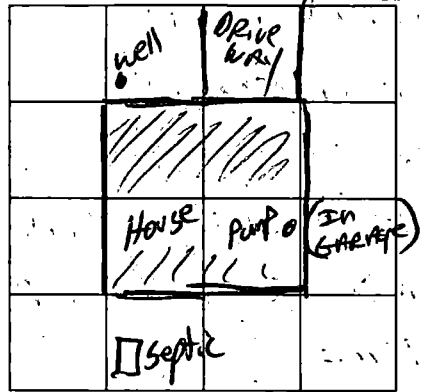

SECTION 28

Please indicate well location X.

ADDITIONAL INFORMATION

Multiple horizontal lines for providing additional information.

RECEIVED

APR 3 1980

Division of Land & Water Resources  
Department of Natural Resources

If more than one screen,  
show location of each on sketch.