

MISSISSIPPI DEPARTMENT OF ENVIRONMENTAL QUALITY

Office of Land and Water Resources

P. O. Box 10631
Jackson, MS 39289-0631

WATER WELL DRILLERS LOG

COUNTY WELL LOCATED HANDOCK	
WELL NUMBER L-2107	CODED
2107	
DATE WELL COMPLETED 6-9-93	

PERMIT NUMBER 0-477
NAME OF DRILLING FIRM PENTON WELL SERV Nicholson, MS.

NAME & MAILING ADDRESS OF LANDOWNER Lillie Mae Hover			
6068 SHAW ST.			
Pearlington, MS. 39572			
WELL LOCATION:	SEC	TOWNSHIP	RANGE
	22	9 S	16 W
DISTANCE	DIRECTION	NEAREST TOWN	
2	E	Pearlington	
OTHER LANDMARK Just across Whites Bayou			
WELL PURPOSE: <input checked="" type="checkbox"/> Home Irrigation, <input type="checkbox"/> Municipal, <input type="checkbox"/> Industrial, <input type="checkbox"/> Fish Pond, etc.			

PUMP DATA		
PUMP TYPE (Circle One): Submersible, Turbine, Jet, Flowing Well, Other (Describe) _____		
POWER TYPE (Circle One): Electric, Tractor, Diesel, Gasoline, Butane, Other (Describe) _____ H/P _____		
Pump Capacity (GPM)	No. of Stages	Setting Depth FT.
PUMP TEST		
Well yielded _____ GPM with a drawdown of _____ ft. after _____ hours of pumping		

WELL DATA		
Well Depth 430	Casing Diameter (In.) 2"	Casing Length (Ft.) 420'
Type of Casing PVC	Hole Depth 430'	Depth to Static Water Level Ground
TYPE OF COMPLETION: (Circle One or More): <input checked="" type="checkbox"/> Gravel Packed, <input type="checkbox"/> Underreamed, <input type="checkbox"/> Telescoped, <input checked="" type="checkbox"/> Natural Development, <input type="checkbox"/> Open Hole, <input type="checkbox"/> Other (Describe) _____		
WELL GROUTED TO A DEPTH OF 10 FEET Type Grout (circle one): Cement, Bentonite, or Mix		

LOG DATA	
TYPE OF LOG RUN (Circle One): <input checked="" type="checkbox"/> No Log Run Electric, Gamma Ray, Density, Sonic, Neutron, Other (Describe) _____	
Name of Organization Running Log	

SCREEN DATA		
Diameter - Inches 2"	Length - Feet 10	Slot Size - Inches 8
Screen Type PVC	Depth to Bottom - Feet 420-430	


GEOLOGIC DATA (Office Use Only)			
Surface Elev.	Geologic Unit	Unit Thickness	Depth to Top
Subs. SWL	Date	Analysis	Aquifer Test
Driller's Remarks			

DESCRIPTION OF FORMATIONS ENCOUNTERED	FROM	TO	FORMATIONS (Continued)	FROM	TO
CLAY	0	60	RECEIVED JUL 15 1993 Dept. of Environmental Quality Office of Land & Water Resources		
SAND	60	100			
CLAY	100	110			
SAND	110	190			
CLAY	190	220			
SAND	220	305			
CLAY	305	315			
SAND	315	430			

IF MORE SPACE IS NEEDED, USE BACK

If well telescopes please sketch and show depths.

GROUND LEVEL

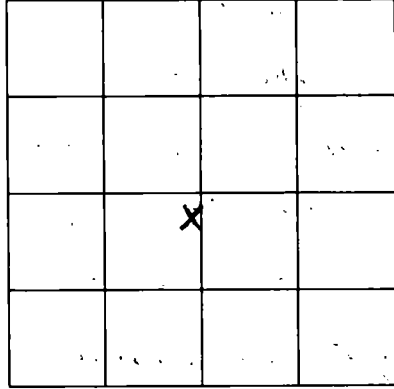

SECTION 22

Please indicate well location X.

ADDITIONAL INFORMATION

If more than one screen,
show location of each on sketch.