

WATER WELL DRILLERS LOG

L 300

Date: 9-24, 1960, Driller: Lucas & Grace ~~Lucas~~ County ~~Lucas~~

(Name)

Hancock

(1) Owner of Land: Mr Tom Doby

(Name)

Oakington Miss

(Address)

(2) Location: 1/4, 1/4, Sec. 28 T. 9 R. 16W

2 1/2 miles North of \_\_\_\_\_  
(distance) (direction) (Nearest Town)

(3) Topography: \_\_\_\_\_

(Hilly)

(Elev)

(Level)

(4) Purpose of Well: Domestic

(Domestic Irrigation  
Municipal, Industrial, Other)

Description & Color of Materials  
Sand, Clay, Red Clay, Shell, etc.

Thick-  
ness  
Feet

Depth  
Feet

Clay -

0

20

Sand -

20

40

Blue Clay

40

80

good sand -

80

120

Information upon completion of well:

(1) Diameter 2 inches.

(2) Total Depth 120 feet.

(3) Water Level 6' feet below top of ground.

(4) Cased to \_\_\_\_\_, Size \_\_\_\_\_

(5) Screen: Size 2", Length 5'


(6) Were any formations sealed against pollution?

\_\_\_\_\_ yes,  no.

If YES depth of formation \_\_\_\_\_

Why \_\_\_\_\_

Drillers Remarks: \_\_\_\_\_

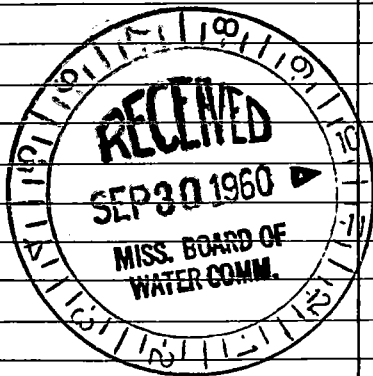

# 30

(Use Back Side)

Well No.