

HANCOCK

WATER WELL DRILLERS LOG

2361

L

9-24-60

Date: 9-24, 1960, Driller: Jack A. Erice County: Hancock

(Name)

Hancock

(1) Owner of Land: George McArthur
 (Name)
Pearlington Miss.
 (Address) SUB DIV

(2) Location: 1/4, 1/4, Sec. T9R16W
2 miles of _____
 (distance) (direction) (Nearest Town)

(3) Topography: X
 (Hilly) (Flat) (Level)

(4) Purpose of Well: Domestic
 (Domestic Irrigation
 Municipal, Industrial, Other)

Description & Color of Materials Sand, Clay, Red Clay, Shell, etc.	Thick- ness Feet	Depth Feet
<u>Clay -</u>	<u>0</u>	<u>50</u>
<u>good sand.</u>	<u>50</u>	<u>77</u>

Information upon completion of well:

(1) Diameter 2 inches.

(2) Total Depth 77 feet.

(3) Water Level 10 feet below top of ground.

(4) Cased to _____, Size _____


(5) Screen: Size _____, Length _____

(6) Were any formations sealed against pollution?
 _____ yes, X no.

If YES depth of formation _____

Why _____

Drillers Remarks: _____

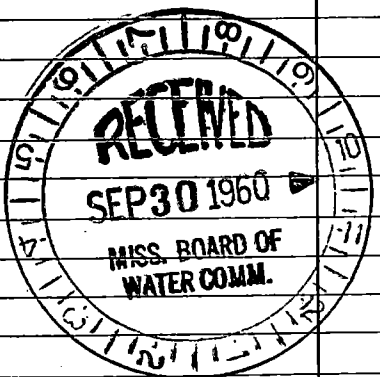

21

(Use Back Side)

Well No.