

L

2300

5-24-61

WATER WELL DRILLERS LOG

Date: 5-24, 1961, Driller: Sutter Well Works County Hancock

(Name)

(1) Owner of Land: P.S. Spans
 (Name)
2033 Magazine St N.O. La.
 (Address)

(2) Location: 1/4, 1/4, Sec. 28 T. 9 R. 16 W.
1/4 miles N of Pearlman
 (distance) (direction) (Nearest Town)

(3) Topography: flat
 (Hilly) (Flat) (Level)

(4) Purpose of Well: domestic
 (Domestic Irrigation
 Municipal, Industrial, Other)


Description & Color of Materials Sand, Clay, Red Clay, Shell, etc.	Thick- ness Feet	Depth Feet
Clay	20	20
Crinity	6	26
Clay	54	80
sand	30	110

Information upon completion of well:

- (1) Diameter 2 inches.
- (2) Total Depth 110 feet.
- (3) Water Level 5 feet below top of ground.
- (4) Cased to ace, Size 2"
- (5) Screen: Size 2", Length 5'
- (6) Were any formations sealed against pollution?
no yes, no.

If YES depth of formation _____
 Why _____

Drillers Remarks: Concrete slab on surface.

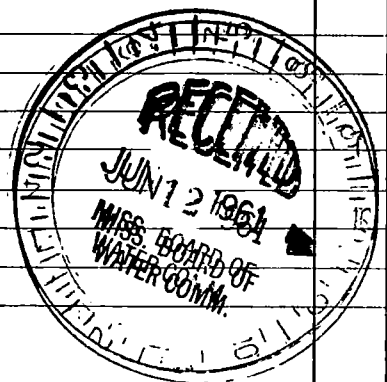

(Use Back Side)

Well No.