

L
7-24-61

WATER WELL DRILLERS LOG

L 301

Date: 7-24, 1961, Driller: Sutter Well Dr. Co. County Hancock

(Name)

(1) Owner of Land: R. H. Earnest
(Name)

4935 Baccich St. - N.O. La.
(Address)


(2) Location: 1/4, 1/4, Sec. 28 T9SR16W

1/2 miles IN of Pearlington
(distance) (direction) (Nearest Town)

(3) Topography: Flat
(Hilly) (Flat) (Level)

(4) Purpose of Well: domestic
(Domestic Irrigation, Municipal, Industrial, Other)

Description & Color of Materials Sand, Clay, Red Clay, Shell, etc.	Thick- ness Feet	Depth Feet
<u>Clay</u>	<u>90</u>	<u>90</u>
<u>Sand</u>	<u>20</u>	<u>110</u>

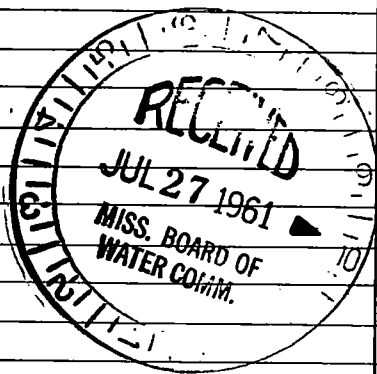

Information upon completion of well:

(1) Diameter 2 inches.

(2) Total Depth 110 feet.

(3) Water level 6 feet below top of ground.

(4) Cased to ace, Size 2"

(5) Screen: Size 2", Length 5'

(6) Were any formations sealed against pollution?

 yes, no.

If YES depth of formation

Why

Drillers Remarks:

Well No.

(Use Back Side)