

Handwritten: *Handwritten* **CODED**

MISSISSIPPI  
BOARD OF WATER COMMISSIONERS  
416 North State Street  
Jackson, Mississippi 39201

**CODED**

Hancock  
**M2**  
4-67

WATER WELL DRILLERS LOG

April 19 68 Pineville Water Works Hancock  
date well completed firm name county well located

LANDOWNER: Charles Johnson  
225 Nicholson Ave, Waukegan  
By St. Louis, Miss  
(mailing address)


description of formations encountered	from	to
Top Soil & Sand	0	20
Mud or Blue clay	20	120
Water sand & but no good	120	135
Blue mud & Clay	135	160
Sand & Blue pe gravel & sand	160	180

WELL LOCATION:  
sec. 35 T. 9 N. R. 13 E.  
2 miles NW of Waukegan  
(distance) (direction) (nearest town)

WELL PURPOSE: Home  
(home, irrigation, municipal, industrial)

- WELL COMPLETION DATA:
- (1) diameter (inches) 2"
  - (2) total depth (feet) 180
  - (3) static water level (feet) 10 below top of ground
  - (4) casing 2" gal. 170'  
(material) (depth)
  - None if telescope see back.  
(size)
  - (5) screen 10' 170'  
(length) (depth to top)
  - 2" Iron gal.  
(size) (material)
  - (6) pump 1/3 350-600 P.M.  
(HP) (yield gpm)
  - Elec.  
(type power)
  - (7) electric log None  
(yes or no)
  - None  
(organization running log)
  - (8) how well bottom plugged 2" B.W.  
Value

Air  
Plead chase  
my address  
to Rt 1 Box 86  
Loy Beach

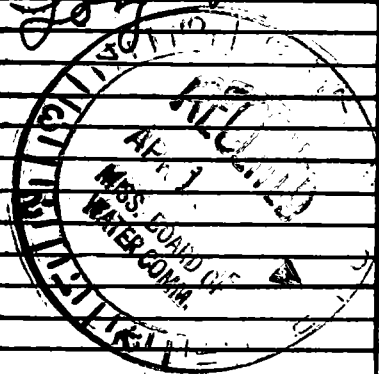

DRILLERS REMARKS:

