

Hancock Co  
 M 8  
 3-11-70

MISSISSIPPI  
 BOARD OF WATER COMMISSIONERS  
 416 North State Street  
 Jackson, Mississippi 39201

**CODED**

WATER WELL DRILLERS LOG

3-11-70 date well completed      1970 Penon Well Serv firm name      Hancock county well located

LANDOWNER:	description of formations encountered	from	to
Sherron Nezaise P.O. Box 55A	Surface clay	0	14
Lakeshore Miss (mailing address)	Mud + Sandy Clay	14	170
	Blue Clay	170	285
	Mud	285	310
	Fine Sand	310	340
	Corey Sand	340	365
<p>WELL LOCATION:</p> <p>sec. 22 T 9 R 15</p> <p>2 miles West of Lakeshore            (distance) (direction) (nearest town)</p> <p>WELL PURPOSE: Home            (home, irrigation, municipal, industrial)</p> <p>WELL COMPLETION DATA: 4 1/2</p> <p>(1) diameter (inches) 2"</p> <p>(2) total depth (feet) 365</p> <p>(3) static water level (feet) 8 below top of ground</p> <p>(4) casing Galv. 360 (material) (depth)            2" (size) if telescope see back.</p> <p>(5) screen 5' 360 (length) (depth to top)            2" S. Steel (size) (material)</p> <p>(6) pump (HP) (yield gpm)            (type power)</p> <p>(7) electric log NO (yes or no)            (organization running log)</p> <p>(8) how well bottom plugged BW Valve</p>			
<p>DRILLERS REMARKS:</p>			


**CO**

APR - 1 1970

MISS. BD. OF  
 WATER COMM.

If well telescopes please sketch and show depths.

GROUND LEVEL

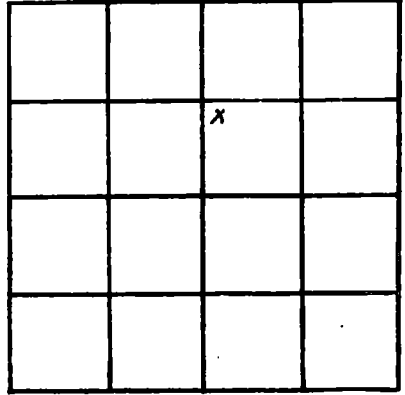

SECTION 22

Please indicate well location X.

ADDITIONAL INFORMATION

Lined area for additional information.

If more than one screen, show locations of each on sketch.