

Hancock
M 10
3-26-70

MISSISSIPPI
 BOARD OF WATER COMMISSIONERS
 416 North State Street
 Jackson, Mississippi 39201

CODED

WATER WELL DRILLERS LOG

march 26 19 70 Fane well works Hancock
 date well completed firm name county well located

LANDOWNER: James J. Norton
Lakeshore miss
5 Portman Lake
 (mailing address)

description of formations encountered	from	to
<u>Red Clay</u>	<u>0</u>	<u>10</u>
<u>Red Clay to blue clay</u>	<u>10</u>	<u>20</u>
<u>sand</u>	<u>20</u>	<u>30</u>
<u>Blue Clay</u>	<u>30</u>	<u>40</u>
<u>blue clay & shales</u>	<u>40</u>	<u>50</u>
<u>1" " " "</u>	<u>50</u>	<u>60</u>
<u>blue clay (hard)</u>	<u>60</u>	<u>70</u>
<u>1" " " "</u>	<u>70</u>	<u>80</u>
<u>sand & clay</u>	<u>80</u>	<u>90</u>
<u>artificial sand gravel</u>	<u>90</u>	<u>100</u>
<u>wash down 5 ft</u>		<u>105</u>

WELL LOCATION:
 sec. 23 T 9 N R. 15 E
 (distance) miles (direction) of (nearest town)

WELL PURPOSE: Home
 (home, irrigation, municipal, industrial)

- WELL COMPLETION DATA:
- (1) diameter (inches) 2
 - (2) total depth (feet) 105
 - (3) static water level (feet) 105 below top of ground.
 - (4) casing plastic (material), 105 (depth)
 - (size) if telescope see back.
 - (5) screen 5 ft (length), 105 (depth to top)
 - (size) 2" (material) plaster
 - (6) pump custom installed (HP) (yield gpm)
 - (type power)
 - (7) electric log (yes or no)
 - (organization running log)
 - (8) how well bottom plugged B.W.V.


CODED

DRILLERS REMARKS:

JUN 22 1970

If well telescopes please sketch and show depths.

GROUND LEVEL

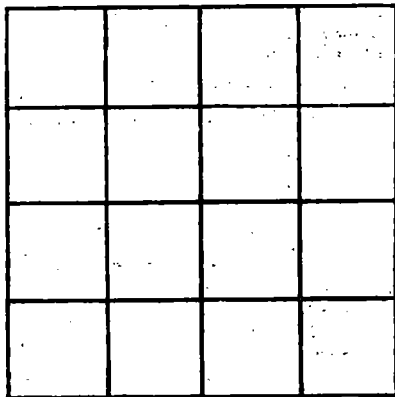

SECTION _____

Please indicate well location X.

ADDITIONAL INFORMATION

If more than one screen, show locations of each on sketch.