

M16
10-17-62

WATER WELL DRILLERS LOG

CODED

Date: 10-17, 1962, Driller: Sutter Well Works County Hancock

(Name)

(1) Owner of Land:	Description & Color of Materials Sand, Clay, Red Clay, Shell, etc.	Thick- ness Feet	Depth Feet
<u>S. J. Cantrell</u> (Name)	<u>Clay</u>	<u>23</u>	<u>23</u>
<u>4740 Eastview bl. N.O La</u> (Address)	<u>sand</u>	<u>17</u>	<u>40</u>
(2) Location: <u>NE 1/4, SW 1/4, Sec. 3 T. 9 N. R. 15 W</u>	<u>Clay</u>	<u>20</u>	<u>60</u>
<u>8</u> miles <u>W</u> of <u>Bay St Louis</u> (distance) (direction) (Nearest Town)	<u>sand</u>	<u>37</u>	<u>97</u>
(3) Topography: <u>flat</u> (Hilly) (Flat) (Level)			
(4) Purpose of Well: <u>domestic</u> (Domestic Irrigation Municipal, Industrial, Other)			

Information upon completion of well:


- (1) Diameter 2 inches.
- (2) Total Depth 97 feet.
- (3) Water level 4 feet below top of ground.
- (4) Cased to all, Size 2"
- (5) Screen: Size 2", Length 5'
- (6) Were any formations sealed against pollution?
no ✓

If YES depth of formation _____

Why _____

Drillers Remarks: _____

CODED

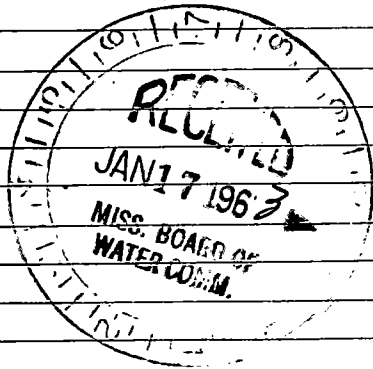

(Use Back Side)

Well No.



12-11-11 12:00 PM

12-11-11
12:00 PM

12-11-11
12:00 PM

12-11-11 12:00 PM
12-11-11 12:00 PM
12-11-11 12:00 PM

12-11-11

12-11-11

