

HANCOCK

M 20
10-2-60

WATER WELL DRILLERS LOG

W-300 (?)

Date: 10-2, 1960, Driller: Duck + Grace County: ^{east river} CODED

(Name)

(1) Owner of Land: Jerry Carco
 (Name)
 Lake Shore Miss.
 (Address)

(2) Location: 1/4, 1/4, Sec. 12, T. 9 R. 5,
 3 miles south Lake Shore
 (distance) (direction) (Nearest Town)

(3) Topography: (Hilly) (Flat) (Level)

(4) Purpose of Well: Domestic
 (Domestic Irrigation
 Municipal, Industrial, Other)

Description & Color of Materials Sand, Clay, Red Clay, Shell, etc.	Thick- ness Feet	Depth Feet
Clay	0	25
Sand	25	50
Clay	50	85
Sand	85	145
Clay	145	280
Sand	280	355
Clay	355	590
Sand	590	840

CODED

Information upon completion of well:

(1) Diameter: 2 1/2 inches.

(2) Total Depth: 840 feet.

(3) Water Level: Flow feet below top of ground.

(4) Cased to _____, Size _____.


(5) Screen: Size 2", Length 20'

(6) Were any formations sealed against pollution?
 _____ yes, _____ no.

Sand we set in was very fine at first but the deeper we drilled, the better it got, set in good grey sand

If YES depth of formation _____
Why _____

Drillers Remarks: 10 lbs Pressure + 30 gal Per Minute.

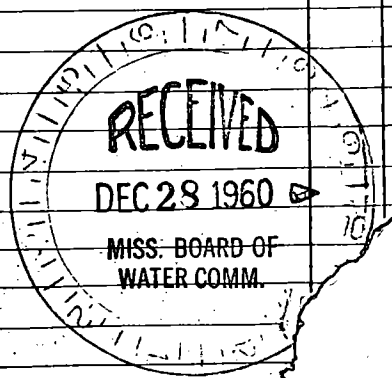

22

(Use Back Side)

[Faint, illegible handwritten text, possibly bleed-through from the reverse side of the page. The text is scattered across the page and includes various words and phrases that are difficult to decipher.]