

M 21

5-17-62

WATER WELL DRILLERS LOG

Date: 5-17, 1962, Driller: Smith & Grace County

(Name)

CODED

(1) Owner of Land: Albert J. Curco (Name)

Lakeshore, Miss. (Address)

(2) Location: 1/4, 1/4, Sec. 13 T 9 N 15

1 miles west of Lakeshore (distance, direction, Nearest Town)

(3) Topography: (Hilly) (Flat) (Level)

(4) Purpose of Well: Domestic (Domestic Irrigation, Municipal, Industrial, Other)

Description & Color of Materials Sand, Clay, Red Clay, Shell, etc.	Thick- ness Feet	Dept Feet
red clays	0	15
white sand	15	50
blue clays	50	90
white sand	90	115
blue clays	115	185
gray sand	185	225
blue clays	225	300
gray sand	300	345
blue clays	345	560
gray sand	560	610
blue clays	610	730
gray sand	730	777

Information upon completion of well:

(1) Diameter 2 inches.

(2) Total Depth 777 feet.

(3) Water Level flowing feet below top of ground.

(4) Cased to _____, Size _____

(5) Screen: Size 2", Length 20'

(6) Were any formations sealed against pollution?

yes, X no.


If YES depth of formation _____

Why _____

Drillers Remarks: _____

CODED

777

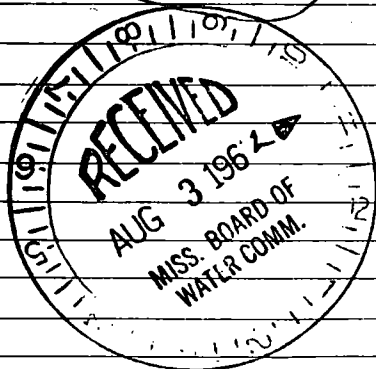

3

(Use Back Side)

Well No.

