

HANCOCK
M 29
7-26-73

MISSISSIPPI
 BOARD OF WATER COMMISSIONERS
 416 North State Street
 Jackson, Mississippi 39201
WATER WELL DRILLERS LOG

CODED

7-26- 1973 J.T. WARD WATER WELLS HANCOCK
 date well completed firm name county well located

LANDOWNER: Duplantion
Bay Side Park
Bay St. Gerin, miss.
 (mailing address)

description of formations encountered	from	to
<u>top Soil - Clay</u>	<u>0</u>	<u>16</u>
<u>SC</u>	<u>16</u>	<u>33</u>
<u>Clay - silt</u>	<u>33</u>	<u>97</u>
<u>SC</u>	<u>97</u>	<u>112</u>
<u>clay - silt</u>	<u>112</u>	<u>155</u>
<u>Red gravel - SC.</u>	<u>155</u>	<u>175</u>

WELL LOCATION:
 sec 1 T 9 N R 15 E
9 miles west of B.S.L.
 (distance) (direction) (nearest town)

WELL PURPOSE: Dom
 (home, irrigation, municipal, industrial)

WELL COMPLETION DATA:

- (1) diameter (inches) 2"
- (2) total depth (feet) 175'
- (3) static water level (feet) 7 ^{below} _{above} top of ground.
- (4) casing 2" PVC 170'
 (material) (depth)
 (size) If telescope see back.
- (5) screen 5' -
 (length) (depth to top)
2" PVC
 (size) (material)
- (6) pump - -
 (HP) (yield gpm)
 (type power)
- (7) electric log NO
 (yes or no)
N/A
 (organization running log)
- (8) how well bottom plugged BWV


CODED

DRILLERS REMARKS: N/A

AUG 29 1973

If well telescopes please sketch and show depths.

GROUND LEVEL

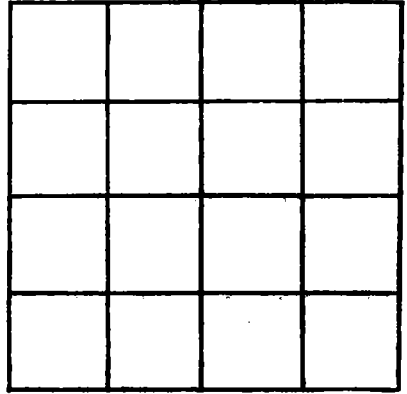

SECTION 1

Please indicate well location X.

ADDITIONAL INFORMATION

If more than one screen, show locations of each on sketch.