

HANCOCK
M 30
8-22-73

MISSISSIPPI
BOARD OF WATER COMMISSIONERS
416 North State Street
Jackson, Mississippi 39201

WATER WELL DRILLERS LOG

CODED

8-22-1973 date well completed
J. T. WARD WATER WELLS firm name
HANCOCK county well located

LANDOWNER: Roland Campbell

Redfish Drive
Bay St. Louis, Miss.
(mailing address)

WELL LOCATION:

sec. 35 T 9 N R 15 E
14 miles SW of B.S.L.
(distance) (direction) (nearest town)

WELL PURPOSE:

(home, irrigation, municipal, industrial)

WELL COMPLETION DATA:

- (1) diameter (inches) 2"
- (2) total depth (feet) 157'
- (3) static water level (feet) 1 ^{below}/_{above} top of ground.
- (4) casing 2" PVC, 152'
(material) (depth)
— if telescope see back.
(size)
- (5) screen 5', —
(length) (depth to top)
2", PVC
(size) (material)
- (6) pump —, —
(HP) (yield gpm)
—
(type power)
- (7) electric log NO
(yes or no)
N/A
(organization running log)
- (8) how well bottom plugged BWU

description of formations encountered

from to

Clay - fill	0	14
sd	14	28
gray clay	28	73
Clay - shell	73	94
sd	94	107
Clay	107	126
Red Brown - sd	126	157

CODED


DRILLERS REMARKS: N/A

SEP 19 1973

MISS. BD. OF
WATER CON.

If well telescopes please sketch and show depths.

GROUND LEVEL

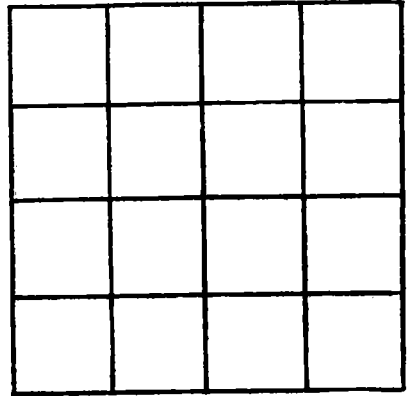

SECTION 30

Please indicate well location X.

ADDITIONAL INFORMATION

If more than one screen, show locations of each on sketch.