

HANCOCK
M 34
2-27-74

MISSISSIPPI
 BOARD OF WATER COMMISSIONERS
 416 North State Street
 Jackson, Mississippi 39201 **CODED**

WATER WELL DRILLERS LOG

2-27 1974
 date well completed

ward well cty.
 firm name

Hancock
 county well located

LANDOWNER: Norman Calamari

description of formations encountered

from to

East Ansbey CALAMARI

fill - clay

0 21

Bay St. Louis, miss.
 (mailing address)

sd
 clay w/ shell

21 32

WELL LOCATION:

sec. 35 T 9 N R 15 E
17 miles west of B.S.L.
 (distance) (direction) (nearest town)

sd
 clay
 sd - Red Head

32 46

46 112

112 144

144 165

WELL PURPOSE: Home
 (home, irrigation, municipal, industrial)

WELL COMPLETION DATA:

- (1) diameter (inches) 2"
- (2) total depth (feet) 165'
- (3) static water level (feet) 2 ^{below} _{above} top of ground.
- (4) casing 2" PVC / 160
 (material) (depth)
 (size) If telescope see back.
- (5) screen 5' / -
 (length) (depth to top)
2" / PVC
 (size) (material)
- (6) pump - / -
 (HP) (yield gpm)
 (type power)
- (7) electric log NO
 (yes or no)
N/A
 (organization running log)
- (8) how well bottom plugged BWU

CODED

RECORDED
INDEXED


MAR 20 1974

DRILLERS REMARKS: N/A

MISS. BD. OF WATER COMMISSIONERS

If well telescopes please sketch and show depths.

GROUND LEVEL

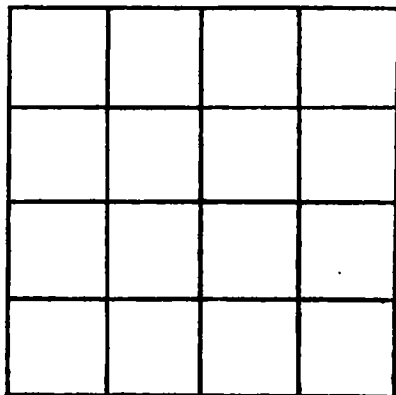

SECTION _____

Please indicate well location X.

ADDITIONAL INFORMATION

If more than one screen, show locations of each on sketch.