

HANCOCK  
M35  
2-12-74

MISSISSIPPI  
BOARD OF WATER COMMISSIONERS  
416 North State Street  
Jackson, Mississippi 39201  
WATER WELL DRILLERS LOG

2-12-1974 date well completed      WARD WELL OLL. firm name      Hancock county well located

LANDOWNER: E. J. Dubose

description of formations encountered	depth	
	from	to
fill - clay	0	21
sd	21	32
clay w/ shell	32	56
sd.	56	107
clay	107	142
st - fine gravel	142	165

3117 arl. St.

Kenner, La. (mailing address)

WELL LOCATION:  
sec. 35 T 9 N R 15 E  
17 miles west of B.S.L.  
(distance) (direction) (nearest town)

WELL PURPOSE: Home  
(home, irrigation, municipal, industrial)


WELL COMPLETION DATA:

- (1) diameter (inches) 2"
- (2) total depth (feet) 165'
- (3) static water level (feet) 1 below top of ground. above
- (4) casing 2" PVC, 160  
(material) (depth)
- If telescope see back.  
(size)
- (5) screen 5', -  
(length) (depth to top)
- 2", PVC  
(size) (material)
- (6) pump -, -  
(HP) (yield gpm)
- (type power)
- (7) electric log NO  
(yes or no)
- WIA  
(organization running log)
- (8) how well bottom plugged BWU

DRILLERS REMARKS: did not furnish pump.

If well telescopes please sketch and show depths.

GROUND LEVEL

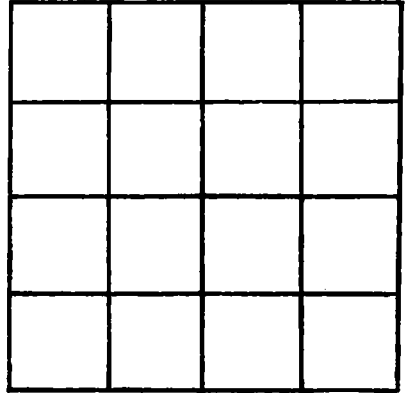

SECTION 35

Please indicate well location X.

ADDITIONAL INFORMATION

If more than one screen, show locations of each on sketch.