

HANCOCK
M 38
3-1-74

MISSISSIPPI
 BOARD OF WATER COMMISSIONERS
 416 North State Street
 Jackson, Mississippi 39201

CODED

WATER WELL DRILLERS LOG

3-1 1974 McKiss Well Works Hancock
 date well completed firm name county well located

LANDOWNER:
Marie Strong
Bay St. Louis, Miss
 (mailing address)

description of formations encountered	from	to
<u>clay</u>	<u>0</u>	<u>13</u>
<u>Coarse Sand</u>	<u>13</u>	<u>38</u>
<u>Blue clay</u>	<u>38</u>	<u>65</u>
<u>Plush</u>	<u>65</u>	<u>97</u>
<u>Coarse Sand</u>	<u>97</u>	<u>125</u>

WELL LOCATION:
 sec. 5 T. 9 N. R. 15 E
2 miles W of Wareland
 (distance) (direction) (nearest town)

WELL PURPOSE: Home
 (home, irrigation, municipal, industrial)

WELL COMPLETION DATA:

(1) diameter (inches) 2"

(2) total depth (feet) 125

(3) static water level (feet) 4' below above top of ground

(4) casing PVC 115'
 (material) (depth)

(size) If telescope see back.

(5) screen 10 115
 (length) (depth to top)

2" PVC
 (size) (material)

(6) pump 1/2 13
 (HP) (yield-gpm)


electric
 (type power)

(7) electric log no
 (yes or no)

(organization running log)

(8) how well bottom plugged sand
shark

CODED

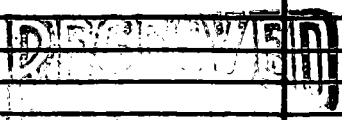

JAN 21 1975

DMM

DRILLERS REMARKS:

If well telescopes please sketch and show depths.

GROUND LEVEL

		X	

SECTION 5

Please indicate well location X.

ADDITIONAL INFORMATION

If more than one screen, show locations of each on sketch.