

**HANCOCK**  
**PM 40**  
**4-16-75**

MISSISSIPPI  
 BOARD OF WATER COMMISSIONERS  
 416 North State Street  
 Jackson, Mississippi 39201

**CODED**

**WATER WELL DRILLERS LOG**

4-16-1975 date well completed      75 Well Well Drilling firm name      Hancock county well located

LANDOWNER: D.J. Masney  
Pleasure St  
Bay St. Louis mini  
 (mailing address)

description of formations encountered	from	to
<u>Silt-clay</u>	<u>0</u>	<u>21</u>
<u>SD</u>	<u>21</u>	<u>38</u>
<u>clay</u>	<u>38</u>	<u>86</u>
<u>SD</u>	<u>86</u>	<u>112</u>
<u>clay-silt</u>	<u>112</u>	<u>312</u>
<u>SD</u>	<u>312</u>	<u>346</u>

WELL LOCATION:  
 sec 24 T 9 N R 15 E  
15 miles S of B.S.L  
 (distance) (direction) (nearest town)

WELL PURPOSE: Home  
 (home, irrigation, municipal, industrial)

- WELL COMPLETION DATA:
- (1) diameter (inches) 2"
  - (2) total depth (feet) 340'
  - (3) static water level (feet) 1 below above top of ground.
  - (4) casing PVC, 330,  
 (material) (depth)  
       if telescope see back.  
 (size)
  - (5) screen 10', -  
 (length) (depth to top)  
2" PVC  
 (size) (material)
  - (6) pump 1/2 8  
 (HP) (yield gpm)  
Elec  
 (type power)
  - (7) electric log NO  
 (yes or no)  
N/A  
 (organization running log)
  - (8) how well bottom plugged BWU


DRILLERS REMARKS: N/A

**RECEIVED**

MAY 19 1975

If well telescopes please sketch and show depths.

GROUND LEVEL

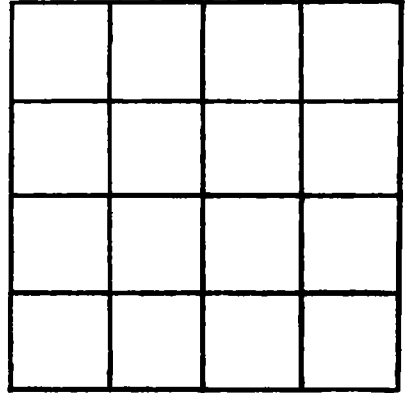

SECTION 24

Please indicate well location X.

ADDITIONAL INFORMATION

If more than one screen, show locations of each on sketch.