

Harcod
M 41
6-6-75


MISSISSIPPI
BOARD OF WATER COMMISSIONERS
416 North State Street
Jackson, Mississippi 39201

CODED

WATER WELL DRILLERS LOG

6-6-1975 ward well drilling Harcod
date well completed firm name county well located


LANDOWNER: <u>Melvin Vainwright - Green St.</u>	description of formations encountered	from	to
<u>Bay St. Louis, Miss.</u> (mailing address)	<u>Top Soil - clay</u>	<u>0</u>	<u>13</u>
WELL LOCATION: sec. <u>6</u> T <u>9</u> N R <u>14</u> E <u>14</u> miles <u>W</u> of <u>B.S.L.</u> (distance) (direction) (nearest town)	<u>sd</u>	<u>13</u>	<u>34</u>
WELL PURPOSE: <u>Home</u> (home, irrigation, municipal, industrial)	<u>clay</u>	<u>34</u>	<u>56</u>
WELL COMPLETION DATA: (1) diameter (inches) <u>2"</u>	<u>clay shell</u>	<u>56</u>	<u>95</u>
(2) total depth (feet) <u>161 ft.</u>	<u>sd</u>	<u>95</u>	<u>116</u>
(3) static water level (feet) <u>7</u> <u>below</u> top of ground.	<u>clay - shell</u>	<u>116</u>	<u>137</u>
(4) casing <u>PVC</u> , <u>156</u> , (material) (depth)	<u>sd & fine gravel</u>	<u>137</u>	<u>161</u>
(5) screen <u>5'</u> , (length) (depth to top)			
(6) pump <u>1/2</u> , <u>7</u> (HP) (yield gpm)			
(7) electric log <u>no</u> (yes or no)			
(8) how well bottom plugged <u>N/A</u>			
DRILLERS REMARKS: <u>N/A</u>			

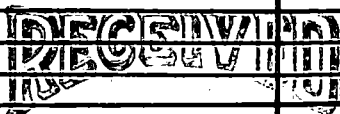

JUL 9 1975

If well telescopes please sketch and show depths.

GROUND LEVEL

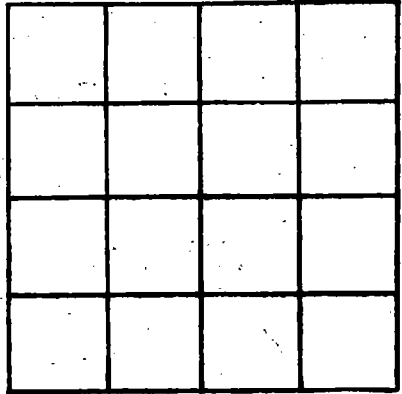

SECTION 6

Please indicate well location X.

ADDITIONAL INFORMATION

If more than one screen, show locations of each on sketch.