

M44

12-16-65

WATER WELL DRILLERS LOG

CODED

Date: 12-16, 1965, Driller: Sutton Well Works County Hancock (Name)

(1) Owner of Land: George Day  
(Name)  
Waveland Miss.  
(Address)

(2) Location: SE 1/4, NW 1/4, Sec. 4 T 9S R 14 W  
1 miles NW of Waveland  
(distance) (direction) (Nearest Town)

(3) Topography: flat  
(Hilly) (Flat) (Level)

(4) Purpose of Well: domestic  
(Domestic Irrigation  
Municipal, Industrial, Other)

Description & Color of Materials Sand, Clay, Red Clay, Shell, etc.	Thick- ness Feet	Depth Feet
Clay	10	10
sand	42	52
Clay	41	93
sand	25	118
Clay	26	144
sand - some gravel	38	186
Clay - sand streak	406	592
sand	93	685
Clay	55	740
sand	55	795
Clay	11	806
sand	10	916
<b>CODED</b>	99	1015
sand	44	1059
Clay	10	1069
sand	21	1190

Information upon completion of well:

(1) Diameter 2 inches.

(2) Total Depth 1190 feet.

(3) Water Level + 36 feet above below top of ground.

(4) Cased to all, Size 2"


(5) Screen: Size 2", Length 25'

(6) Were any formations sealed against pollution?  
yes,  no.

If YES depth of formation \_\_\_\_\_

Why \_\_\_\_\_

Drillers Remarks: \_\_\_\_\_

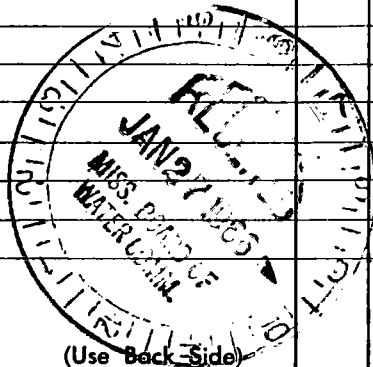

Well No.

Handwritten header text, possibly a title or address, including the word "MICHIGAN" and "STATE".

Vertical column of handwritten text on the left side of the page, containing names and possibly dates.

Handwritten text in the upper right quadrant, including the word "MICHIGAN" and other illegible words.

Handwritten text in the lower right quadrant, including the word "MICHIGAN" and other illegible words.

Large area of handwritten text at the bottom of the page, containing multiple lines of illegible cursive writing.