

MISSISSIPPI DEPARTMENT OF NATURAL RESOURCES

Bureau of Land and Water Resources

Southport Mall

P.O. Box 10631

Jackson, Mississippi 39209

WATER WELL DRILLERS LOG

Grener Drilling Service, Inc.

CODED
Hancock

HANCOCK
M49
6-2-81

date well completed

firm name

county well located

6-2-81

LANDOWNER:
South La. Production
P.O. Box 52088
Lafayette, La 70505
(mailing address)

description of formations encountered

from

to


sand & pea gravel 0 189
clay & sand 189 670
sand 670 714

WELL LOCATION: *460' N + 660' E*
sec. 19 T-9 N R-15 E of
#1 Amaley Field
(distance) (direction) (nearest town)

WELL PURPOSE: *oil field*
(home, irrigation, municipal, industrial)

WELL COMPLETION DATA:

- (1) diameter (inches) *4"*
- (2) total depth (feet) *714'*
- (3) static water level (feet) *Flowing*
top of ground.
- (4) casing *steel, 714'*
(material) (depth)
4"
(size) If telescope see back.
- (5) screen *42' 672'*
(length) (depth to top)
4" perforated
(size) (material)
- (6) pump *- 100*
(HP) (yield gpm)
ac
(type power)
- (7) electric log *-*
(yes or no)
-
(organization running log)
- (8) how well bottom plugged *orange*
pull

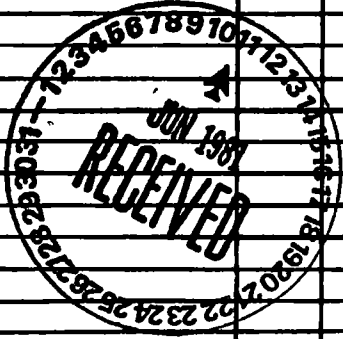

DRILLERS REMARKS:

If well telescopes please sketch and show depths.

GROUND LEVEL

| | | | |
|--|--|--|-----|
| | | | |
| | | | 150 |
| | | | |
| | | | |

SECTION _____

Please indicate well location X.

ADDITIONAL INFORMATION



If more than one screen, show locations of each on sketch.