

MISSISSIPPI DEPARTMENT OF NATURAL RESOURCES

Bureau of Land and Water Resources

Southport Mall

P.O. Box 10631

Jackson, Mississippi 39209

WATER WELL DRILLERS LOG

GRINER DRILLING SERVICE, INC.

Hancock

HANCOCK
M 50
11/14/82

11-14-82 date well completed

GRINER DRILLING SERVICE, INC. firm name

Hancock county well located

LANDOWNER:	description of formations encountered	from	to
Celeron, Inc. P.O. Box 52088 Lafayette, La. 70505 (mailing address)	clay, SAND	0	167
	SAND	167	210
WELL LOCATION: 660' N + 1960' W sec. 19 T. 9 N. R. 15 E. S4/100	streaked	210	270
No. 200 Ansley Field I-10 miles (distance) of (direction) (nearest town)	sand, pea gravel	270	315
WELL PURPOSE: oil field supply (home, irrigation, municipal, industrial)	clay, small sand breaks	315	550
WELL COMPLETION DATA:			
(1) diameter (inches) 4"			
(2) total depth (feet) 550			
(3) static water level (feet) ground above top of ground.			
(4) casing steel 315' (material) (depth) 4" (size) if telescope see back.			
(5) screen 42' 273' (length) (depth to top) 4" perforated (size) (material)			
(6) pump - 80 (HP) (yield gpm) AC (type power)			
(7) electric log _____ (yes or no) (organization running log)			
(8) how well bottom plugged Oldinge peel			
DRILLERS REMARKS:			

CODED


DEPT. OF NATURAL RESOURCES
BUREAU OF LAND & WATER RESOURCES

NOV 22 1982

RECEIVED

If well telescopes please sketch and show depths.

GROUND LEVEL

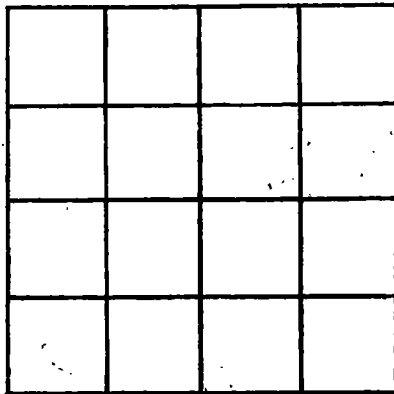

SECTION _____

Please indicate well location X.

ADDITIONAL INFORMATION

If more than one screen, show locations of each on sketch.