

MISSISSIPPI DEPARTMENT OF NATURAL RESOURCES

Bureau of Land and Water Resources

Southport Mall

P.O. Box 10631

Jackson, Mississippi 39209

WATER WELL DRILLERS LOG

CODED

M5
Hanrock
8-20-83

20 aug. 1983 date well completed
Ward Well Dlg. firm name
Hanrock county well located

LANDOWNER: John Suska
Lakeshore Rd.
Bay St. Louis, ms.
(mailing address)

description of formations encountered	from	to
top. Sal. clay	0	12
sd	12	46
clay	46	95
Red. Mudpst. - sd	95	110
clay - silt	110	226
sd	226	265
clay - silt	265	490
sd	490	538
clay - silt	538	775
Coarse sd	775	840

WELL LOCATION:
sec. 1 T. 8 N. R. 13 E.
9 S. 15 W.
10 miles W of Waveland
(distance) (direction) (nearest town)

WELL PURPOSE: Home
(home, irrigation, municipal, industrial)

WELL COMPLETION DATA:

(1) diameter (inches) 2"

(2) total depth (feet) 840'

(3) static water level (feet) 10 below top of ground.

(4) casing PVC, 820' (material) (depth)

(size) If telescope see back.

(5) screen 20' (length) (depth to top)

2" PVC (size) (material)

(6) pump owner (HP) (yield gpm)

(type power)

(7) electric log NO (yes or no)

N/A (organization running log)

(8) how well bottom plugged BWV

DEPT. OF NATURAL RESOURCES
BUREAU OF LAND & WATER RESOURCES


OCT 17 1983

RECEIVED

DRILLERS REMARKS: N/A
2 PSI - 20 GPM

If well telescopes please sketch and show depths.

GROUND LEVEL

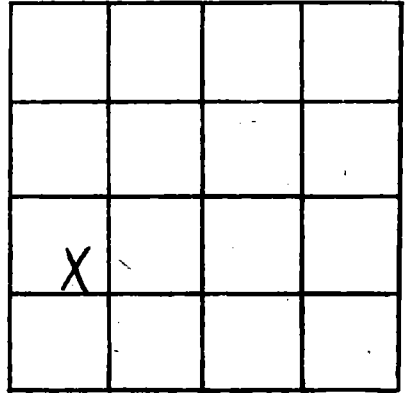

SECTION 1

Please indicate well location X.

ADDITIONAL INFORMATION

If more than one screen,
show locations of each on sketch.