

MISSISSIPPI DEPARTMENT OF NATURAL RESOURCES

Bureau of Land and Water Resources

Southport Mall

P.O. Box 10631

Jackson, Mississippi 39209

WATER WELL DRILLERS LOG

CODED

Griner Drilling Service, INC.

Hancock

Hancock
M 53
1/11/85

date well completed

firm name

county well located

LANDOWNER:

See Land Drilling Co
900 Dunn Street
Houma, La. 70360

(mailing address)

description of formations encountered

from

to

sand

0 30

streaked, mostly clay

30 147

WELL LOCATION: *2000'S & 1100'W*

sec *30* T *9* N R *15* E of

No. 1 Cuyers miles *Ansley Field* (distance) (direction) (nearest town)

sand, pea gravel

147 210

WELL PURPOSE: *oil field supply*
(home, irrigation, municipal, industrial)

WELL COMPLETION DATA:

- (1) diameter (inches) *3"*
- (2) total depth (feet) *210'*
- (3) static water level (feet) *10'* below above top of ground.

- (4) casing *steel, 210'*
(material) (depth)

3"
(size) If telescope see back.

- (5) screen *42', 168'*
(length) (depth to top)

3" perforated
(size) (material)

- (6) pump *-* *75*
(HP) (yield gpm)

AC
(type power)

- (7) electric log (yes) (no)

(organization running log)

- (8) how well bottom plugged *orange*
peel

DRILLERS REMARKS:


CODED

RECEIVED
JAN 24 1985

Department of Natural Resources
Bureau of Land & Water Resources

If well telescopes please sketch and show depths.

GROUND LEVEL

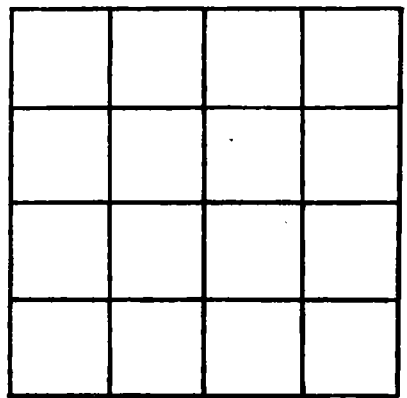

SECTION _____

Please indicate well location X.

ADDITIONAL INFORMATION

Lined area for additional information.

If more than one screen, show locations of each on sketch.