

MISSISSIPPI DEPARTMENT OF NATURAL RESOURCES

Bureau of Land and Water Resources

Southport Mall

P.O. Box 10631

Jackson, Mississippi 39209

WATER WELL DRILLERS LOG

CODED

Hancock
M55

12-9-

19

82 Ward Well Drg

Hancock

date well completed

firm name

county well located

LANDOWNER:

Genevieve Brubaker

description of formations encountered

from

to

Cemetery Rd.

Top Soil - clay

0 15

Bay St. Louis ms.
(mailing address)

sd

15 36

clay

36 67

Red gravel - sd

67 94

clay

94 110

Red gravel - sd

110 136

Clay - silt

136 274

Sand - silt

274 337

Clay - silt

337 794

Coarse sd

794 840

WELL LOCATION:

sec 27 T 9 N R 14 E
(distance) miles 6 S/W of LAKE SHORE
(direction) (nearest town)

WELL PURPOSE:

Home
(home, irrigation, municipal, industrial)

WELL COMPLETION DATA:

- (1) diameter (inches) 2"
- (2) total depth (feet) 840
- (3) static water level (feet) 15 below top of ground. (above)
- (4) casing PVC 820
(material) (depth)
(size) If telescope see back.
- (5) screen 20' -
(length) (depth to top)
2" PVC
(size) (material)
- (6) pump owner
(HP) (yield gpm)
(type power)
- (7) electric log NO
(yes or no)
N/A
(organization running log)
- (8) how well bottom plugged BWU

DRILLERS REMARKS:

N/A


DEPT OF NATURAL RESOURCES
BUREAU OF LAND & WATER RESOURCES

JAN 31 1983

RECEIVED

If well telescopes please sketch and show depths.

GROUND LEVEL

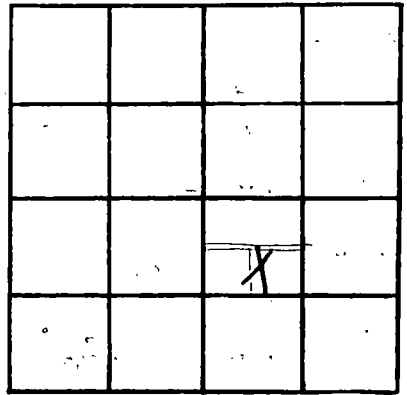

SECTION 27

Please indicate well location X.

ADDITIONAL INFORMATION

If more than one screen, show locations of each on sketch.