

MISSISSIPPI DEPARTMENT OF NATURAL RESOURCES

Bureau of Land and Water Resources

Southport Mall

P.O. Box 10631

Jackson, Mississippi 39209

WATER WELL DRILLERS LOG

CODED

Hancock
~~KAZ MS8~~
 10-2-82

10-2-1982 Ward Well Dg. Hancock
 date well completed firm name county well located

LANDOWNER: John Bass
Lower Bay Rd.
Bay St. Louis, ms.
 (mailing address)

description of formations encountered	from	to
<u>Top Soil - Clay</u>	<u>0</u>	<u>16</u>
<u>sd</u>	<u>16</u>	<u>48</u>
<u>clay</u>	<u>48</u>	<u>105</u>
<u>Red gravel - sd</u>	<u>105</u>	<u>122</u>
<u>Clay</u>	<u>122</u>	<u>150</u>
<u>Red gravel - sd</u>	<u>150</u>	<u>167</u>
<u>Clay - silt</u>	<u>167</u>	<u>520</u>
<u>sd</u>	<u>520</u>	<u>536</u>
<u>Clay - silt</u>	<u>536</u>	<u>894</u>
<u>Coarse sd</u>	<u>894</u>	<u>945</u>
<u>Clay - silt</u>	<u>945</u>	<u>1160</u>
<u>Coarse sd</u>	<u>1160</u>	<u>1182</u>

WELL LOCATION: 15
 sec. 4 T. 8 N. R. 12 E.
6 miles W of Warland
 (distance) (direction) (nearest town)

WELL PURPOSE: Home
 (home, irrigation, municipal, industrial)

WELL COMPLETION DATA:

(1) diameter (inches) 2"

(2) total depth (feet) 1182

(3) static water level (feet) 20 below above top of ground.

(4) casing Galv. 1162
 (material) (depth)

(size) if telescope see back.

(5) screen 20 -
 (length) (depth to top)

2" Stainless Steel
 (size) (material)

(6) pump - -
 (HP) (yield gpm)

(type power)

(7) electric log NO
 (yes or no)

NIA
 (organization running log)

(8) how well bottom plugged BWU

DEPT. OF NATURAL RESOURCES
 BUREAU OF LAND & WATER RESOURCES


NOV 22 1982

RECEIVED

DRILLERS REMARKS: 15 P.S.I.
58 G.P.M.

If well telescopes please sketch and show depths.

GROUND LEVEL

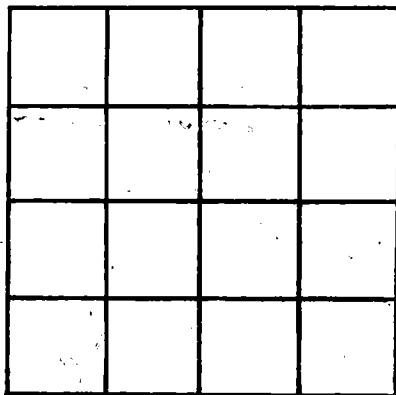

SECTION 4

Please indicate well location X.

ADDITIONAL INFORMATION

If more than one screen, show locations of each on sketch.