

HANCOCK
~~MARKER~~
 M 62
 4-3-85

MISSISSIPPI DEPARTMENT OF NATURAL RESOURCES
 Bureau of Land and Water Resources
 Southport Mall
 P.O. Box 10631
 Jackson, Mississippi 39209
WATER WELL DRILLERS LOG

CODED

4-3-1985 date well completed 95 WARD WELL DLG. firm name Hancock county well located

LANDOWNER: Claude Pittman III
P.O. Box 280
Reaughton, ms.
 (mailing address)


description of formations encountered	from	to
Clay	0	12
Clay - silt	12	25
Coarse sd	93	120

WELL LOCATION:
 sec. 29 T. 9 N. R. 7 E
6 miles S/E of Reaughton
 (distance) (direction) (nearest town)

WELL PURPOSE: Home
 (home, irrigation, municipal, industrial)

WELL COMPLETION DATA:

- (1) diameter (inches) 2"
- (2) total depth (feet) 120
- (3) static water level (feet) 5 ^{below} _{above} top of ground.
- (4) casing PVC 110'
 (material) (depth)
 (size) if telescope see back.
- (5) screen 10'
 (length) (depth to top)
2" PVC
 (size) (material)
- (6) pump owner
 (HP) (yield gpm)
 (type power)
- (7) electric log NO
 (yes or no)
N/A
 (organization running log)
- (8) how well bottom plugged BWU

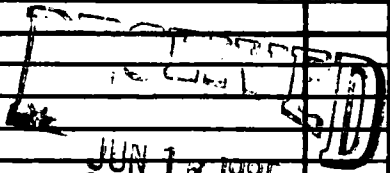


JUN 17 1985

Department of Natural Resources
 Bureau of Land & Water Resources

DRILLERS REMARKS: N/A

If well telescopes please sketch and show depths.

GROUND LEVEL

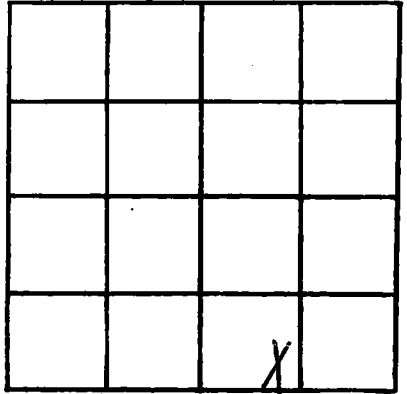

SECTION 29

Please indicate well location X.

ADDITIONAL INFORMATION

If more than one screen, show locations of each on sketch.