

MISSISSIPPI DEPARTMENT OF NATURAL RESOURCES

Bureau of Land and Water Resources

Southport Mall

P.O. Box 10631

Jackson, Mississippi 39209

WATER WELL DRILLERS LOG

CODED.

HANCOCK
M 63
3-15-86

Griner Drilling Service, Inc.

Hancock

3-15-86 date well completed

Griner Drilling Service, Inc. firm name

Hancock county well located

LANDOWNER:
Celeron Oil & Gas
P.O. Box 52088
Lafayette, La. 70505
(mailing address)

description of formations encountered	from	to
sand	0	60
clay	60	85
sand	85	195
clay	195	210

WELL LOCATION: 660' S & 1960' W of
sec. 30 T. 9 N R. 15 E of
No. 2-A Ansley Field
1.2 miles (distance) N (direction) of (nearest town)

WELL PURPOSE: oil field rig
(home, irrigation, municipal, industrial)

WELL COMPLETION DATA:

(1) diameter (inches) 4"

(2) total depth (feet) 210'

(3) static water level (feet) 7' below top of ground.

(4) casing steel (material), 189' (depth)
4" (size) if telescope see back.

(5) screen 42' (length), 147' (depth to top)
4" (size), perforated (material)

(6) pump (HP) 80 (yield gpm)
AC (type power)

(7) electric log NO (yes or no)

147' depth

RECEIVED
APR 15 1986

(organization running log)


(8) how well bottom plugged orange
peel

DRILLERS REMARKS:

Department of Natural Resources
Bureau of Land & Water Resources

If well telescopes please sketch and show depths.

GROUND LEVEL

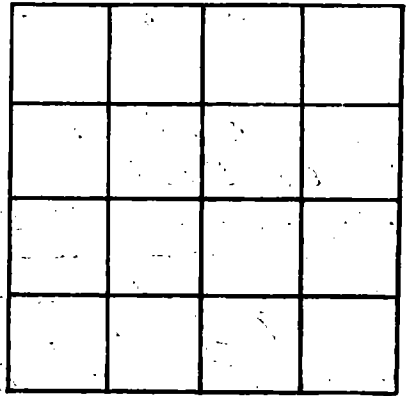

SECTION _____

Please indicate well location X.

ADDITIONAL INFORMATION

If more than one screen, show locations of each on sketch.