•						
	is to sail	1	State Well Report			
County: HANCOCK			Part 1 – Driller's Log Mississippi Department of Environmental Quality			
Permit #:			d Water Resources	Aquifer: Well #: M-84		
Driller: N	echise well	P.O. Bo	x 10631			
	g completed: 12-607		39289-0631 51-5210	L. S. Elevation:		
Date detinin	g completed.		6938 (fax)	E-log #:		
		oort be prepared by the licen ss within 30 days of comple				
Depu	Information on Wel			rehole Location		
(.	Landowner if borehole is not	t for a water well)	Latitude: ° ·	" Longitude: ° '		
Owner Nar	ne Griffetrean	m Guulomit		" Longitude:°'		
Mailing Ar	idress: 7082/11	HHINGH.	Method of Lat Long (circle or	ic): Conventional Survey,		
USGS quad. Hand-held GPS, Survey-grade GPS						
	have CI Do	1112 100 9	½ ½ Sec_1 7	Twn 95 Rng 15		
	Bay St. do	uu, y , y , y				
	• •	• • • • •	Miles	of LAILESHORE		
Telephone	No. (239) 549-7	(1.8)				
		Well / Boreh	ole Data	•		
Date drillir	a started 12-10-07 Date	drilling completed: 12-60	7 Hole danth: 110	Hole diameter:		
		- • •				
Location o Method of	f the source of any surface w dosing and volume of Chlor	ater used for drilling:	pment:	4 WATER - Solue		
Logs run (a Name of o	circle all applicable): No log rganization running log(s):		Density Sonic Neutron	Other:		
Purpose of	borchole (check one): Water	Well Geotechnical Geolog	rical Investigation Ground	Source Heat Pump		
		ic Survey Other (describe)				
	If drilling is not relat	ted to water well construction.	skip the remainder of this bl	ock		
Purpose of	Well (check one): Home 🗹	Industrial Public Supply	Irrigation Fish Culture	Other:		
If a flowing	g well, method of flow regula	tion: Valve Oth	er (describe)			
Static Wate	er Level: <u>IZ</u> feet	above of below (circle one) las	nd surface Date measured:	12-6-07		
Method of	Measurement (circle one) (steel tape electric tape	air line other:	······································		
Well depth	Well grouted to a	depth of <u>IC</u> feet Type o		ent Bentonite Mix		
Casing len	gth: 100 feet Ca	using diameter: <u>Z</u>	inches Type of casing:			
Screen len	gth: <u>IC</u> feet So	creen diameter: <u>Z'</u>	inches Type of screen:	PUC		
		s Setting depth: From	100 feet to 11	Dfeet		
Type of co	mpletion (circle all applicable	e): Gravel packed Underre	amed Telescoped Open	hole Natural Development		
		Other (describe):				
Top of lap	pipe or reduction in casing:	feet. If tele	scoped or more than one scre	en, describe on next page		
				Form: OLWR-SW		

RECEIVED JAN 2 2 2008 BY: OLWR


The sketch below only required for water wells

fwell	<u>telescope</u>	s. show a	enths or	ı sketch.
Gro	ound Leve			

wells and boreholes, unless specifically exempted by regulations From (depth) **Description of Formations Encountered** To (depth) Ground Level 20 Ø \mathbf{C}

Description of formations encountered must be provi

If more than one screen, show location of each on sketch

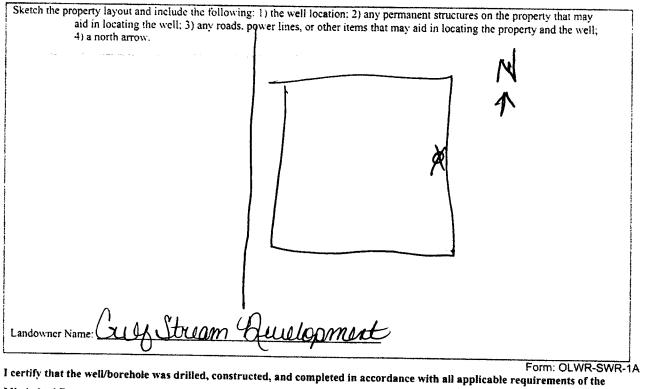

Mississippi Department of Environmental Quality and the Mississippi Department of Health regulations, if applicable, and state

 (\mathcal{L}) NECASE - 0-660

Print Name of Responsible Licensee and License No.

Date

-05 RECEIVED

JAN 2 2 2008

BY: OLWR

Signature of Licensee

STATE WELL REPORT								
Driller: NECHEST WELL Date completed: 01-14-08 Copy information from block on Part 1	Pump Installer's Mississippi Departmen Office of Land a P.O. E Jackson, N (601) (601)35	art 2 5 Completion Report t of Environmental Quality ind Water Resources 30x 10631 15 39289-0631 961-5210 44-6938 (fax) contractor or a licensed pump in	For Office Use Only: Aquifer: Well #: <u>M - 8 4</u> Elevation: Istaller. A copy of Part 1 of the					
This part of the report must be completed by a licensed water well contractor or a licensed pump installer. A copy of Part 1 of the report must be attached and both parts filed with the Department at the above address within 30 days of well completion.								
Well Owner Information Owner Name: Cull Strum 4	ulppment		Location Longitude:					
Mailing Address: 708 3 11 MUU	KOT.	Method of Lat/Long (check one): Conventional Survey,						
DUJ St. GOILO City State Telephone No. (239) 549-7718	Zip Code	USGS quad, Hand-held GPS, Survey-grade GPS 44 Sec_1Z_T_9_R_15 Distance Direction Nearest Town Miles_Nof <u>LAKES HORE</u>						
D								
Pump Type Circle one		Power Type Circle onc						
Air Lift Jet Su	ubmersible		e Engine Natural Gas					
Bucket Piston Tu	irbine	Electric Motor Hand	Tractor PTO					
Centrifugal Rotary Fl	lowing Well	Windmill Other (s	specify):					
Other (specify):		Horse Power Rating of Motor:						
Date Pump Installed: 01-14-08	3	Setting Depth: 40 feet						
Rated Pump Capacity:Ga	llons Per Minute	Number of Stages:						
Pump Test Data Date Well Tcsted:			asuring Water Level rcle one					
Static Water Level (A):Feet Bel Pumping Water Level (B):Feet Belo		Air Line Electric Meas Other (specify):						
Drawdown [(B) - (A)]:Feet Bel	ow Land Surface	For flowing well, measured shut in head:feet						
Test Pumping Rate:Gal	llons Per Minute	Well yieldedGPM with a drawdown of						
Duration of Pump Test (minimum 4 hours):	hours	feet after	hours of pumping					
LHEREBY CERTIFY that the above statement <u>KOPENT</u> NECKED Print Name of Pump Installer and License No. (660	Emy knowledge. Column Signature of Pump Ins						

e 1

JAN 2 2 2008 BY: OLWR