	State Well Report			
County: HANCECK	Part 1 - Driller's Log	For Office Use O		
ermit #:	Mississippi Department of Environmental Quality Office of Land and Water Resources	Aquifer: $M - 9$ . Well #: $M - 9$ .		
Driller: NECHIGE WELL	P.O. Box 10631	1		
Date drilling completed: 2.20.08	Jackson, MS 39289-0631 (601)961-5210	L. S. Elevation:		
	(601)354-6938 (fax)	E-log #:		
	rt be prepared by the license holder responsible for			
Department at the above address Information on Well (	within 30 days of completion of drilling of the well Owner Well or B	l or borehole. orehole Location		
(Landowner if borehole is not fo		" Longitude: "		
Owner Name Blue Cah	CUMPLICION	-		
Mailing Address: 7241 SUV	ntlatter Method of Lat Long (circle c	me): Conventional Surve		
USGS quad. Hand-held GPS, Survey-grade GPS				
Paulostanijoms Va Sec_Z Twn 4 Rng				
Ciry Sta		Neasest Town		
Telephone No. 239, 549-771	8	of <u>num</u>		
	Well / Borehole Data			
Date drilling started 22008 Date dr	illing completed 2:2008 Hole depth: 120'	Hole diameter:		
	er used for drilling: HANCOCK COUNT			
Method of dosing and volume of Chloring	c used in drilling and development:			
Logs run (circle all applicable): No log ru	D Electric Gamma Ray Density Sonic Neutron	Other:		
Name of organization running log(s):	1	δ.		
Purpose of borchole (check one): Water W	Electric Gamma Ray Density Sonic Neutron fell Geotechnical Geological Investigation Groun Survey Other (describe)	d Source Heat P		
Seismic : If drilling is not valated	SurveyOther ( <i>describe</i> ) <i>to water well construction, skip the remainder of this b</i> ndustrialPublic SupplyIrrigationFish Culture on: ValveOther (describe)	MAD		
Purpose of Wall (check on c). If use of the	to where well construction, skip the remainder of Inis o	BV. 83		
rapose of wen (check one). Home v	ndustrial Public Supply Irrigation Fish Culture	- Other		
It a flowing well, method of flow regulatio	on: Valve Other (describe)			
Static Water Level:feet ab	nove of below (circle one) land surface Date measured:	2-210-08		
Method of Measurement (circle one) (st				
Well depth: 130 Well grouted to a de	pth of the feet Type of grout (circle one): Neat Cer	nent Bentonite (Mix		
Casing length: <u>110</u> feet Casir		PVC		
Screen length: <u>IC</u> feet Scree	· · · · ·	PUC		
Screen slot size: <u>COC</u> inches Setting depth: From <u>110</u> feet to <u>120</u> feet				
	Gravel packed Underreamed Telescoped Oper	hole Natural Develop		

Form: OLWR-SWR-1A

N - 95


## The sketch below only required for water wells

If well telescopes, show depths on sketch. Ground Level\_

Description of formations encountered must be provided for all wells and boreholes, unless specifically exempted by regulations

	Description of Formations Encountered	From (depth)	To (depth)
-		Ground Level	
	MUD	0	20
	SAND,	<u> 910</u>	60
	B.CIAY	$\omega O$	90
	SANIS	90	120
	l		
			+
		+	
			+
		+	+
			<del> </del> {
			<del> </del>
		<b>*******</b>	+
		1	+
		1	++
	· · · · · · · · · · · · · · · · · · ·		
		† <del></del>	1
			1
			1
			1
		1	

If more than one screen, show location of each on sketch

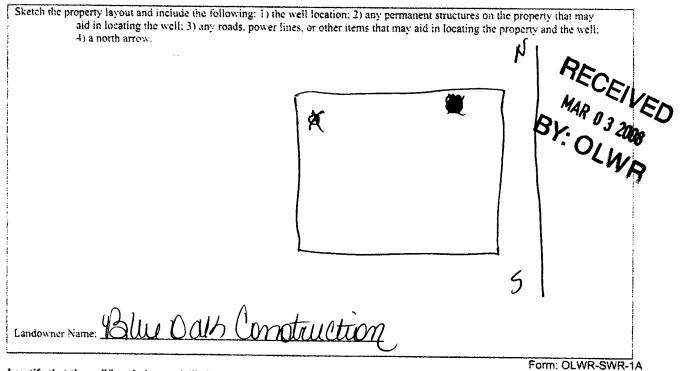

I certify that the well/borehole was drilled, constructed, and completed in accordance with all applicable requirements of the Mississippi Department of Environmental Quality and the Mississippi Department of Health regulations, if applicable, and state

Laws. 2.20-00 NECHAN

Signature of Licensee

Print Name of Responsible Licensee and License No.

Date

STATE WELL REPORT						
County: Permit #: Driller: NECHIST WILL Date completed:7-0 8 Capy information from black on Part 1	Part 2 Pump Installer's Completion Report Mississippi Department of Environmental Quality Office of Land and Water Resources P.O. Box 10631 Jackson. MS 39289-0631 (601)961-5210 (601)354-6938 (fax)		For Office Use Only:           Aquifer:           Weil #:			
This part of the report must be completed l	hy a licensed water well (	ontractor or a licensed numn is	nstallar A conv of Part 1 of the			
report must be attached and both parts file	d with the Department a	t the above address within 30 de	ays of well completion.			
Owner Name: Bue Oak Onotuction		Well Location Latitude:Longitude:				
Mailing Address: 704/ Sunflower		Method of Lat Long (check one): Conventional Survey,				
Bay St. Jours MS Ciry State Zip Code Telephone No. (239), 549-7718		USGS quad, Hand-held GPS, Survey-grade GPS ½ ½ Sec 12T R15 Distance Direction Nearest Town Miles of Add to bottle				
L			·····			
Pump Type Circle one		Power Type Circle one				
Air Lift Jet	Submersible	Diesel Engine Gasolin	e Engine Natural Gas			
Bucket Piston	Turbine	Electric Motor Hand	Tractor PTO			
Centrifugal Rotary	Flowing Well	Windmill Other (	specify):			
Other (specify):		Horse Power Rating of Motor:				
Date Pump Installed:		Setting Depth:feet				
Rated Pump Capacity:	Gallons Per Minute	Number of Stages:				
Pump Test Data		Method of Me	asuring Water Level			
Date Well Tested:		Ci	rcle one			
Static Water Level (A):Feet Below Land Surface Pumping Water Level (B):Feet Below Land Surface		Air Line Electric Mea				
Drawdown [(B) – (A)]:Feet Below Land Surface		For flowing well, measured sh	ut in head:feet			
Test Pumping Rate:Gallons Per Minute		Well yielded GPM with a drawdown of				
Duration of Pump Test (minimum 4 hours):	hours	feet afterhours of pumping				
LHEREBY CERTIFY that the above statem KOPENT NECHKE ( Print Name of Pump Installer and License N	)-660 °	Signature of Pump In	staller Form: OLWR-SWR-1B			

• A .....

-

.

APR 18 2008 BY: OLWR