•				
County hancal	Well Driller Report and Well Log		For Office Use Only:	
Permit #	Mississippi Department of Environmental Quality		Aquifei	
Duller Emer	Office of Land and Water Resources P.O. Box 10631		Well # M-105	
Date drilling completed 3-12-08	Jackson, N	1S 39289-0631	1 S Elevation	
		961-5210 4-6938 (fax)	E-log #	
State Law requires that this 30 days of completion of dril	report be prepared by the	driller in detail and filed with	n the Department within	
Well Owner Infor	mation	Wel	Location	
Owner Name Gulf Coust	ant Group		NLongitude 089 . 26 897 .	
Mailing Address:	I		ne): Conventional Survey, 54	
1200 Beach &	202 50 + 904	USGS quad, Hand-held	I GPS, Survey-grade GPS	
City City	MS State Zip Code	.5W 1/4_NE Sec_12	Twn 95 Rng 15	
Telephone No. ()		Distance Direction Miles	Nearest Town	
		Data ecret S		
Purpose of Well (circle one Home				
Date well drilling started: 3-16		y Irrigation Fish Culture	2 1 2 2 8	
If flowing, method of flow regulation:	Valve Utha	· (decerile)	2-12-03	
Static Water Level: 15				
Static Water Level: <u>15</u> fee Method of Measurement (circle one)			ed: 3-12-08	
Hole depth: 115 Well			175	
29 A A A A A A A A A A A A A A A A A A A			of <u>10</u> feet	
		IX		
Casing length: /OO_feet C	asing diameter: <u>9</u>	inches Type of casing	sch40°	
Screen length: 10 feet	Screen diameter: <u>4</u>	inches Type of screen	Sch400	
Screen slot size: <u>61</u> inch	es Setting depth: From	100 feet to /	10 feet	
Type of completion (circle all applicab	le): Grevel packed Und	derreamed Telescoped O	pen hole Natural Development	
	Other (describe):			
Top of lap pipe or reduction in casing:	feet. If	telescoped or more than one	screen, describe on back of page	
Logs run (circle all applicable) No log	Brun Electric Gamma R	ay Density Sonic Neutron	Other:	
I certify that the well was drilled, constructed, Environmental Quality and/or the Mississippi	and completed in accordance w Department of Health regulatio	ith all applicable requirements of the	Mississippi REGEIVED	
		<i>¶</i>	MAR 2 5 2008	
Bernind Edmosin	0-743	file	BY: OLWR	
Print Name of Water Well Contractor a	ind License No.	Signature of	Water Well Contractor	


If well telescopes please sketch below and show depths

11

.

M-105

	Description of Formations Encountered	From To	,
	Sand	0 11	C
	with culte of Bray	nch 10 8	
	deman sa l	213	
	blackson		à
	greench	60 7	29
	5 mg ch	808	
	untered.	90 11	
			Ľ
			·
			_
			· · · ·
ŀ			
ore than one screen, show location of each on sl	etch	· · · · · · · · · · · · · · · · · · ·	

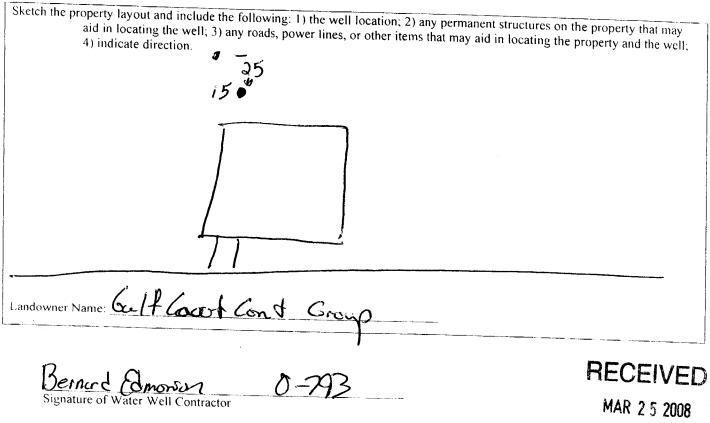

BY: OLWR

			ELL REPORT			
County hancel	2		art 2 Completion Report	For Office Use Only:		
County hanced		Mississippi Departmen Office of Land a	t of Environmental Quality nd Water Resources Box 10631	Aquiter Well # M-	105	
Date completed 3-12	00	Jackson, M (601)	IS 39289-0631 961-5210	Elevation		
This report m installation of	ust be prepared pump. A copy o	by the nump installer in	4-6938 (fax) detail and filed with the Do ust be attached to this repo	epartment within 2	30 days of the	
We	ell Owner Inforn	nation	Well Location			
Owner Name: Gulf Coot Cont Group			Latitude: 300/6, 305 Longitude 08926,8974			
Mailing Address:			Method of Lat/Long (circle one): Conventional Survey,			
1200 Beach blud, sent 904 Gent Mont City State Zip Code			USGS quad, Hand-held GPS, Survey-grade GPS			
Cit	y Sta	ate Zip Code	SW NE Sec	12 Twn 95	$Rng_{15}W$	
			Distance Direction	n Nearest To	wn	
Telephone No. ()		Miles of				
			ect	Smith		
	Pump Type Circle one			ower Type Circle one		
Air Lift	Jet	Submersible	Diesel Engine Gas	soline Engine	Natural Gas	
Bucket	Piston	Turbine	Electric Motor Ha	nd	Tractor PTO	
Centrifugal	Rotary	Flowing Well	Windmill Oth	her (specify):		
Other (specify):		······	Horse Power Rating of Mc	1		
Date Pump Installed: 3-12-08			Setting Depth:	·(`)	· · · · · · · · · · · · · · · · · · ·	
Rated Pump Capacity	20	Gallons Per Minute	Number of Stages:	3	feet	
	Pump Test Dat		Method of N	Acasuring Water Le	vel	
Date Well Tested:	3-12-0	0		Circle one		
Static Water Level (A): 15 Feet Below Land Surface			Air Line Electric Measuring Line Steel Tape			
Pumping Water Level	(B): 25	eet Below Land Surface	Other (specify):			
Drawdown (B) – (A)	<u> </u>	Feet Below Land Surface	For flowing well, measure	d shut in head	F	
Test Pumping Rate:	20	Gallons Per Minute	Well yiclded			
Duration of Pump Tes			feet afte			
		atements are true to the be	st of my knowledge.	RI	ECEIVED	
Print Name of Pump I	Month Installer and Lice	nse No. (if applicable)	1/2/			
	and the	noe (no. (11 applicable)	Signature of Pump Ins		MAR 2 5 2008	
				B	COLWR	

.

· · ·

r

•