

Part 2 never received 3/13

State Well Report Part 1 - Driller's Log

County: Winnick
 Permit #: _____
 Driller: Necaise Well Service
 Date drilling completed: 4-22-08

Mississippi Department of Environmental Quality
 Office of Land and Water Resources
 P.O. Box 10631
 Jackson, MS 39289-0631
 (601)961-5210
 (601)354-6938 (fax)

For Office Use Only:
 Aquifer: _____
 Well #: M-122
 L. S. Elevation: _____
 E-log #: _____

State Law requires that this report be prepared by the license holder responsible for the work and filed with the Department at the above address within 30 days of completion of drilling of the well or borehole.

Information on Well Owner (Landowner if borehole is not for a water well)	Well or Borehole Location
Owner Name: <u>Juanita Nunez</u>	Latitude: <u>30° 16' 51"</u> Longitude: <u>89° 26' 47"</u>
Mailing Address: <u>7080W. Casagueras</u>	Method of Lat/Long (circle one): Conventional Survey, USGS quad. Hand-held GPS. Survey-grade GPS
<u>Bay St Louis MS</u> City State Zip Code	NE 1/4 NE 1/4 Sec <u>12</u> Twn <u>9S</u> Rng <u>15W</u>
Telephone No. () _____	Distance <u>2</u> Miles Direction <u>W</u> of Nearest Town <u>Rabohou</u>

Well / Borehole Data

Date drilling started: 4-22-08 Date drilling completed: 4-22-08 Hole depth: 100' Hole diameter: 4"

Location of the source of any surface water used for drilling: Winnick City Water & Sewer

Method of dosing and volume of Chlorine used in drilling and development: _____

Logs run (circle all applicable): No log run Electric Gamma Ray Density Sonic Neutron Other: _____

Name of organization running log(s): _____

Purpose of borehole (check one): Water Well Geotechnical/Geological Investigation _____ Ground Source Heat Pump _____

Scismic Survey _____ Other (describe) _____

If drilling is not related to water well construction, skip the remainder of this block

Purpose of Well (check one): Home Industrial _____ Public Supply _____ Irrigation _____ Fish Culture _____ Other: _____

If a flowing well, method of flow regulation: Valve _____ Other (describe) _____

Static Water Level: 12 feet above or below (circle one) land surface Date measured: 4-22-08

Method of Measurement (circle one): steel tape electric tape air line other: _____

Well depth: 100 Well grouted to a depth of 10 feet Type of grout (circle one): Neat Cement Bentonite Mix

Casing length: 90 feet Casing diameter: 2" inches Type of casing: PVC

Screen length: 10 feet Screen diameter: 2" inches Type of screen: PVC

Screen slot size: .006 inches Setting depth: From 90 feet to 100 feet

Type of completion (circle all applicable): Gravel packed Underreamed Telescoped Open hole Natural Development

Other (describe): _____

Top of lap pipe or reduction in casing: _____ feet. *If telescoped or more than one screen, describe on next page*

Form: OLWR-SWR-1A


RECEIVED
 JUN 06 2008
 BY: OLWR

The sketch below only required for water wells

Description of formations encountered must be provided for all wells and boreholes, unless specifically exempted by regulations

If well telescopes, show depths on sketch


Ground Level

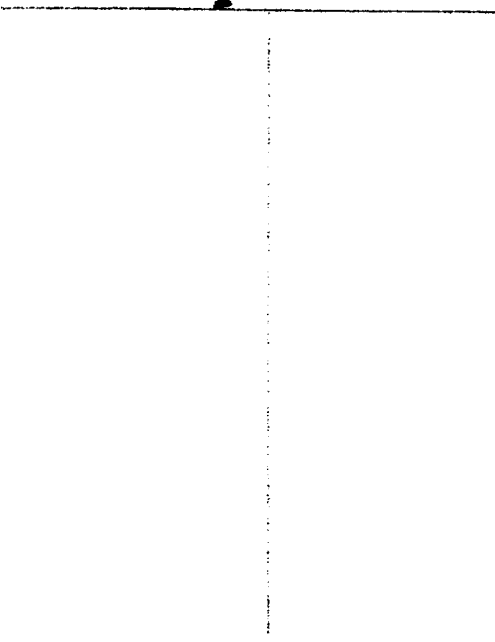

Description of Formations Encountered	From Depth (Ground Level)	To Depth
MUD	0	20
SAND	20	50
CLAY	50	80
SAND	80	100

If more than one screen, show location of each on sketch

Sketch the property layout and include the following: 1. the well location; 2. any permanent structures on the property that may aid in locating the well; 3. any roads, power lines, or other items that may aid in locating the property and the well; 4. a north arrow.

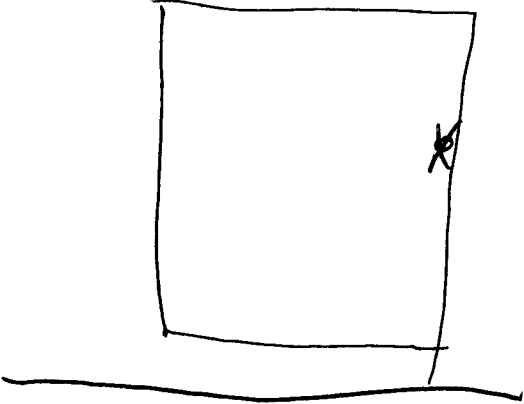

Inspector Name Freeman Abma

Form: OLWR-SWR-1A

I certify that the well/borehole was drilled, constructed, and completed in accordance with all applicable requirements of the Mississippi Department of Environmental Quality and the Mississippi Department of Health regulations, if applicable, and state laws.

ROBERT NEASE - 0-160 4-22-08
Print Name of Responsible Licensee and License No. Date

[Signature]
Signature of Licensee

RECEIVED
JUN 06 2008
BY: OLWR