

M 2000

8-28-62

WATER WELL DRILLERS LOG

M

Date: 8-28, 1962, Driller: Sutter Well Works County Hancock

(Name)

(1) Owner of Land: G. Bunch (Name)

3026 Orleans St., N.O. La. (Address)

(2) Location: SW 1/4, NE 1/4, Sec. 34 T. 28 R. 15 W. 1/2 miles IN of Anselmy (direction) (Nearest Town)

(3) Topography: flat (Level)

(4) Purpose of Well: domestic home (Domestic Irrigation, Municipal, Industrial, Other)

Description & Color of Materials Sand, Clay, Red Clay, Shell, etc.

Thickness Feet

Depth Feet

Clay
sand

100
14
114

Information upon completion of well:

(1) Diameter 1 1/2 inches.

(2) Total Depth 114 feet.

(3) Water Level 2" above flow (2" below top of ground)

(4) Cased to 109 feet, Size 1 1/2"


(5) Screen: Size 1 1/2", Length 5'

(6) Were any formations sealed against pollution? no.

If YES depth of formation

Why

Drillers Remarks:

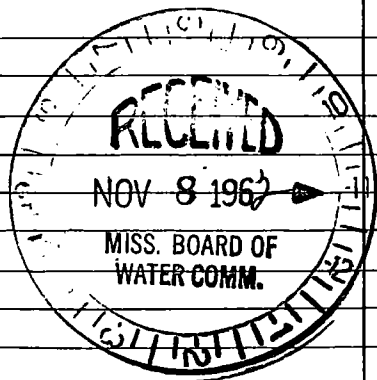

(Use Back Side)

Well No.

Handwritten notes on lined paper, including the word "Liberated" and other illegible scribbles.

Liberated

Liberated

Liberated

L

Liberated

L

L

L