

HANCOCK

MISSISSIPPI BOARD OF WATER COMMISSIONERS

M 2005

7-17-64

WATER WELL DRILLERS LOG

Date: 7-17, 1964, Driller: Sutton Well Works County Hancock

(Name)

(1) Owner of Land: Elmer Rupp (Name)

6610 General Haig - n.o., La (Address)

(2) Location: SE 1/4, NE 1/4, Sec. 34 T9S R15W

miles 1W of Analey (distance) (direction) (Nearest Town)

(3) Topography: flat (Hilly) (Flat) (Level)

(4) Purpose of Well: Domestic Home (Domestic Irrigation Municipal, Industrial, Other)

Information upon completion of well:

(1) Diameter 2 inches.

(2) Total Depth 152 feet.

(3) Water Level 1 feet above ground. (124.7)

(4) Cased to all, Size 2"

(5) Screen: Size 2", Length 5'


(6) Were any formations sealed against pollution? yes, no.

If YES depth of formation

Why

Drillers Remarks:

Description & Color of Materials Sand, Clay, Red Clay, Shell, etc.	Thick- ness Feet	Depth Feet
Clay - sand streaks	102	102
Sand	17	119
Clay	16	135
Sand	17	152

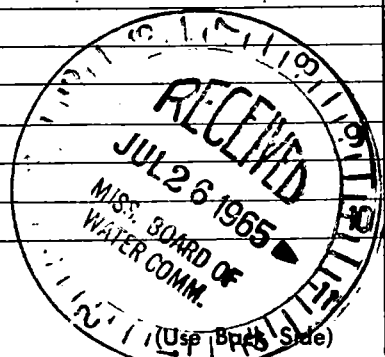

Well No.

Handwritten text at the top of the page, possibly a header or title.

Handwritten text in the upper middle section, appearing to be a list or series of notes.

Handwritten text in the middle right section, possibly a signature or a specific note.

Handwritten text in the lower middle section, possibly a date or a reference.

Handwritten text in the lower right section, possibly a small note or mark.