

HANCOCK

MISSISSIPPI BOARD OF WATER COMMISSIONERS

M-7007

9-29-64

WATER WELL DRILLERS LOG

M

Date: 9-29, 1964, Driller: Sutton Wells Water County Hancock

(Name)

(1) Owner of Land: Jas. Ecosta (Name)

2331 Laurel - N.O. La. (Address)

(2) Location: SW 1/4, NE 1/4, Sec 24 T9S R15W

miles 1N, of Anselmy (distance) (direction) (Nearest Town)

(3) Topography: flat (Hilly) (Flat) (Level)

(4) Purpose of Well: domestic Home (Domestic Irrigation Municipal, Industrial, Other)

Information upon completion of well:

(1) Diameter 2 inches.

(2) Total Depth 117 feet. Flow

(3) Water Level 1 feet below top of ground. above

(4) Cased to 117' depth, Size 2"

(5) Screen: Size 2", Length 5'

(6) Were any formations sealed against pollution?

yes, no.

If YES depth of formation Surface

Why

Drillers Remarks:

Description & Color of Materials Sand, Clay, Red Clay, Shell, etc.

Thick-ness Feet

Depth Feet

Clay

20

20

Sand

26

46

Clay - sand streaks


59

105

Sand - gravel

12

117

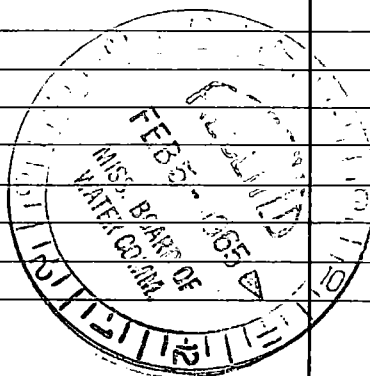

(Use Back Side)

Well No.

The first part of the document
 discusses the general principles
 of the system. It is
 divided into two main sections.
 The first section deals with
 the theoretical aspects, while
 the second section focuses on
 practical applications.



The second part of the document
 provides a detailed description
 of the system's components.
 It includes a list of the
 various parts and their
 functions. This section is
 essential for understanding
 how the system operates.

The final part of the document
 contains a summary of the
 findings. It highlights the
 key points and provides
 recommendations for further
 research. The document
 concludes with a statement
 of the author's gratitude.