

M 2009

4-1-65

WATER WELL DRILLERS LOG

A

Date: 4-1, 1965, Driller: Sutter Well Works County Hancock
 (Name)

(1) Owner of Land: Continental Resort
 (Name)
East Anselmy, Miss.
 (Address)

(2) Location: SW 1/4, NE 1/4, Sec. 4 T15S R15W
2 miles W of Anselmy
 (distance) (direction) (Nearest Town)

(3) Topography: flat
 (Hilly) (Flat) (Level)

(4) Purpose of Well: domestic Home
 (Domestic Irrigation
 Municipal, Industrial, Other)

Description & Color of Materials Sand, Clay, Red Clay, Shell, etc.	Thick- ness Feet	Depth Feet
Clay	4	4
sand	13	17
Clay	27	44
sand	21	65
Clay	13	78
sand	18	96
Clay	16	112
sand	53	165

Information upon completion of well:

(1) Diameter 6 inches.

(2) Total Depth 165 feet.

(3) Water Level 1 feet below top of ground.

(4) Cased to 150 feet, Size 6"


(5) Screen: Size 6", Length 15'

(6) Were any formations sealed against pollution?
 yes, no.

If YES depth of formation surface

Why _____

Drillers Remarks: _____

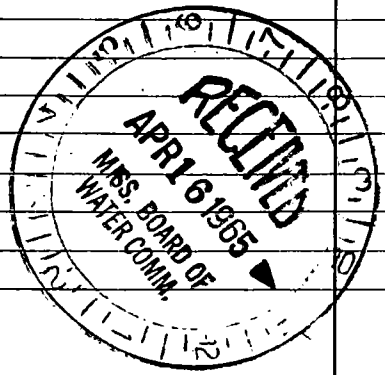

(Use Back Side)

Well No. _____

