

HANCOCK

M-2010

4-28-65

MISSISSIPPI BOARD OF WATER COMMISSIONERS

WATER WELL DRILLERS LOG

Date: 4-28, 1965, Driller: Sutter Well Works County Hancock (Name)

(1) Owner of Land: Paul J. Brown (Name) Anslay Miss. (Address) (2) Location: NW 1/4, SE 1/4, Sec. 27 T9S R 15, W (distance) 1/2 miles (direction) N, at Anslay (Nearest Town) (3) Topography: flat (Hilly) (Flat) (Level) (4) Purpose of Well: domestic home (Domestic Irrigation Municipal, Industrial, Other)

Table with 3 columns: Description & Color of Materials (Sand, Clay, Red Clay, Shell, etc.), Thickness Feet, Depth Feet. Rows contain handwritten entries: Clay 43, sand 15, Clay 44, sand 19.


Information upon completion of well:

(1) Diameter 2 inches. (2) Total Depth 121 feet. (3) Water Level 5 feet below top of ground. (4) Cased to 1 1/2' above, Size 2". (5) Screen: Size 2", Length 5'. (6) Were any formations sealed against pollution? [checked] yes, [ ] no.

If YES depth of formation Surface

Why

Drillers Remarks:

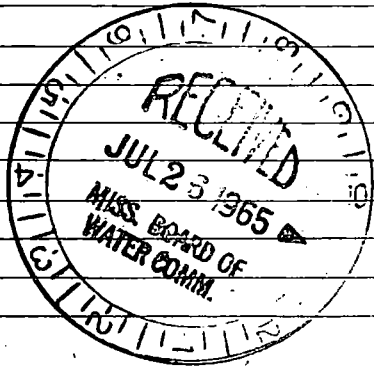

(Use Back Side)

Well No.

