

HANCOCK  
M 2011

MISSISSIPPI BOARD OF WATER COMMISSIONERS

4-27-65

WATER WELL DRILLERS LOG

Date: 4-27, 1965, Driller: Jutter Well Wks. County Hancock

(Name)

(1) Owner of Land: Francis E. Heath  
(Name)

Ansley, Miss.  
(Address)

(2) Location: SE 1/4, NE 1/4, Sec. 34 T9S R15W

         miles IN of Ansley  
(distance) (direction) (Nearest Town)

(3) Topography: flat  
(Hilly) (Flat) (Level)

(4) Purpose of Well: domestic home  
(Domestic Irrigation  
Municipal, Industrial, Other)

Description & Color of Materials  
Sand, Clay, Red Clay, Shell, etc.

Thick-  
ness  
Feet

Depth  
Feet

Clay 21 21

sand 16 37

Clay - sand streaked 89 126

sand 26 152

Information upon completion of well:

(1) Diameter 2 inches.

(2) Total Depth 152 feet.

(3) Water Level 1/2 feet above <sup>(FDW)</sup> below top of ground.

(4) Cased to gall, Size 2"


(5) Screen: Size 2", Length 5'

(6) Were any formations sealed against pollution?  
         yes,  no.

If YES depth of formation         

Why         

Drillers Remarks:         

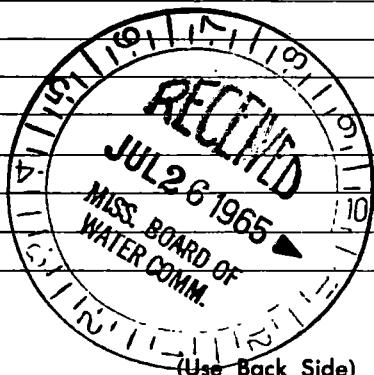

Well No.

Account of the ...

Journal of ...

18 ...  
19 ...  
20 ...

... ..  
... ..

... ..  
... ..

1831

... ..  
... ..  
... ..