

M 2012

4-27-65

WATER WELL DRILLERS LOG

Date: 4-27, 1965, Driller: Sutter Well Works County Hancock

(Name)

(1) Owner of Land: Glenn Karnif (Name)

4109 Constance St. N.O. La. (Address)

(2) Location: NW 1/4, NW 1/4, Sec. 34 T9S R15 W

miles IN of Analogy (distance) (direction) (Nearest Town)

(3) Topography: flat (Hilly) (Flat) (Level)

(4) Purpose of Well: domestic Home (Domestic Irrigation Municipal, Industrial, Other)

Description & Color of Materials Sand, Clay, Red Clay, Shell, etc.	Thick-ness Feet	Depth Feet
Clay	45	45
sandy clay	34	79
Clay	69	148
sand	19	167

Information upon completion of well:

(1) Diameter 2 inches.

(2) Total Depth 167 feet.

(3) Water Level 2 feet below top of ground. 162

(4) Cased to all, Size 2"


(5) Screen: Size 2", Length 5'

(6) Were any formations sealed against pollution? yes, no.

If YES depth of formation Surface

Why

Drillers Remarks:

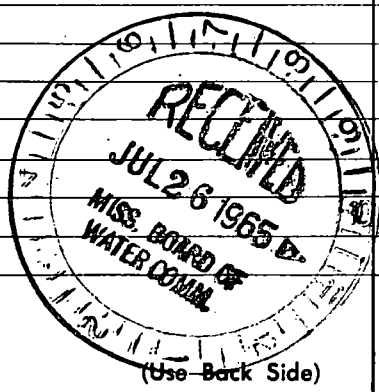

Well No.

Handwritten text at the top of the page, possibly a title or header.

Handwritten text in the upper middle section, appearing to be a list or series of notes.

Handwritten text in the middle section, continuing the notes or list.

Handwritten text in the lower middle section, possibly a summary or conclusion.

Handwritten text at the bottom of the page, including what appears to be a signature or date.