

Hancock
 M 2013
 12-66

MISSISSIPPI
 BOARD OF WATER COMMISSIONERS
 416 North State Street
 Jackson, Mississippi 39201

WATER WELL DRILLERS LOG

12-20 1966 SUTTER WELL WORKS Hancock
 date well completed firm name county well located

LANDOWNER: JOHN HOSE

LAKE SHORE, MISS.

(mailing address)

WELL LOCATION:


sec 22 T 9 S R 15 W
 4 miles W of LAKE SHORE
 (distance) (direction) (nearest town)

WELL PURPOSE: Home
 (home, irrigation, municipal, industrial)

WELL COMPLETION DATA:

- (1) diameter (inches) 2
- (2) total depth (feet) 155
- (3) static water level (feet) 5 below top of ground
- (4) casing GALV. (material) 150' (depth)
 2" (size) If telescope see back.
- (5) screen 5' (length) 150' (depth to top)
 2" (size) S.S. (material)
- (6) pump 1/2 (HP) 15 (yield gpm)
 FLEC. (type power)
- (7) electric log No (yes or no)
 (organization running log)
- (8) how well bottom plugged B.P. VALVE

description of formations encountered	from to	
CLAY	0	22
SAND	22	46
CLAY	46	70
SAND	70	118
CLAY	118	137
SAND	137	155

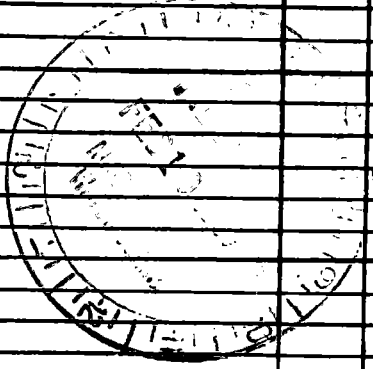

DRILLERS REMARKS:

