

Hancock  
 177 2015

6-16-66 MISSISSIPPI BOARD OF WATER COMMISSIONERS

**WATER WELL DRILLERS LOG**

Date: 6-16, 1966, Driller: Little Well Works County Hancock  
 (When well drilled) (Name) (Where well is located)

(1) Owner of Land: Geo. Lufish  
 (Name)  
Buht Louis  
 (Address)

(2) Location: NE 1/4, NW 1/4, Sec. 13 T 9 S R 15 W  
1 miles N of Lakeshore  
 (distance) (direction) (Nearest Town)

(3) Topography: flat  
 (Hilly) (Flat) (Level)

(4) Purpose of Well: domestic home  
 (Domestic Irrigation  
 Municipal, Industrial, Other)

Description & Color of Materials Sand, Clay, Red Clay, Shell, etc.	Thick- ness Feet	Depth Feet
Clay	8	8
Sand	52	60
Clay	28	88
Sand	32	120
Clay	63	183
sand	11	194

Information upon completion of well:

(1) Diameter 2 inches.

(2) Total Depth 194 feet.

(3) Water Level 6 feet below top of ground.  
189

(4) Cased to all, Size 2"

(5) Screen: Size 2", Length 5'

(6) Were any formations sealed against pollution?  
 yes,  no.

If YES depth of formation \_\_\_\_\_


Why \_\_\_\_\_

Drillers Remarks: \_\_\_\_\_

Yield in gpm: 15

Size pump: Unknown

Type power: \_\_\_\_\_

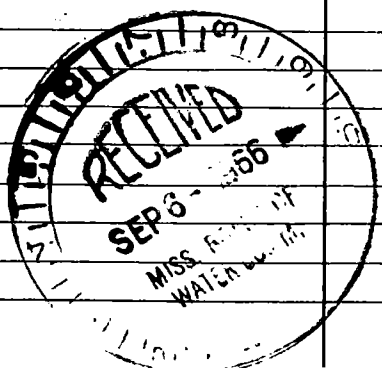

Mail this copy to Board of Water Commissioners 429 Miss. St. Jackson, Miss.

