

Hancock
M 2016
2-67

MISSISSIPPI
BOARD OF WATER COMMISSIONERS
416 North State Street
Jackson, Mississippi 39201

WATER WELL DRILLERS LOG

2-1 1967 Sutter Well Works Hancock
date well completed firm name county well located

LANDOWNER: Donald Burch

Lakeshire, Miss.

(mailing address)

description of formations encountered

from

to

Clay	0	10
Sand	10	35
Clay	35	90
Sand	90	127
Clay	127	178
Sand	178	196

WELL LOCATION:


sec. 12 T. 9 S. R. 15 E. W. 1
2 miles N of Lakeshire
(distance) (direction) (nearest town)

WELL PURPOSE: Home
(home, irrigation, municipal, industrial)

WELL COMPLETION DATA:

- (1) diameter (inches) 2
- (2) total depth (feet) 196
- (3) static water level (feet) 7 below above top of ground.
- (4) casing galv. 190'
(material) (depth)
- _____ if telescope see back.
(size)
- (5) screen 6' 190'
(length) (depth to top)
- 2" stainless steel
(size) (material)
- (6) pump unknown
(HP) (yield gpm)
- _____ (type power)
- (7) electric log No
(yes or no)
- _____ (organization running log)
- (8) how well bottom plugged B.P. Valve

DRILLERS REMARKS:

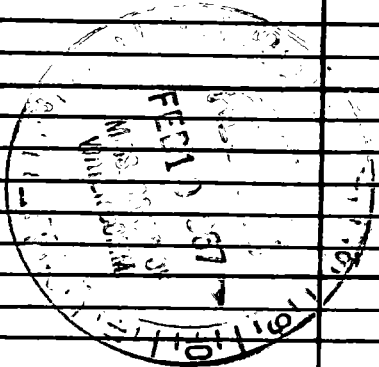

If well telescopes please sketch and show depths.

GROUND LEVEL

			X

SECTION 12

Please indicate well location X.

ADDITIONAL INFORMATION

If more than one screen, show locations of each on sketch.