

Hancock
M 2017
5-67

MISSISSIPPI
BOARD OF WATER COMMISSIONERS
416 North State Street
Jackson, Mississippi 39201

WATER WELL DRILLERS LOG

5-29 1967 date well completed
Lutter Well Works firm name
Hancock county well located

LANDOWNER: R. AUTHEMENT

Box 2100

Keesler AFB, Miss
(mailing address)

WELL LOCATION:

sec. 12 T. 9 S. R. 15 W.
4 miles W of Bay St Louis
(distance) (direction) (nearest town)

WELL PURPOSE: home
(home, irrigation, municipal, industrial)


WELL COMPLETION DATA:

- (1) diameter (inches) 2
- (2) total depth (feet) 193
- (3) static water level (feet) 9 below top of ground.
- (4) casing galv. (material), 188' (depth)
2" (size) if telescope see back.
- (5) screen 5' (length), 188' (depth to top)
2" (size), stainless steel (material)
- (6) pump unknown (HP), (yield gpm)
(type power)
- (7) electric log no (yes or no)
(organization running log)
- (8) how well bottom plugged BP Value

description of formations encountered

from to


Clay	0	7
Brown Sand	7	55
Clay	55	110
Sand	110	114
Clay	114	180
Sand	180	193

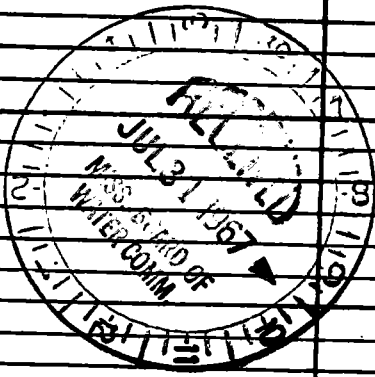

DRILLERS REMARKS:

If well telescopes please sketch and show depths.

GROUND LEVEL

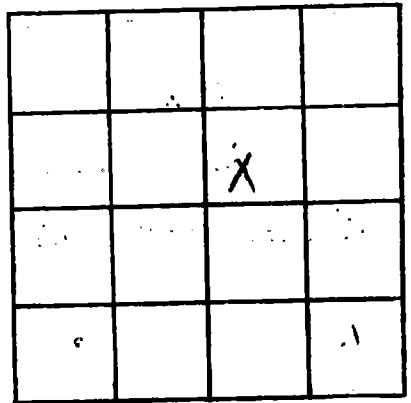

SECTION 6

Please indicate well location X.

ADDITIONAL INFORMATION

If more than one screen, show locations of each on sketch.